Paper weight-110# (minimum)

Black nonfading ink required

U.S. PUBLIC LAND SURVEY MONUMENT RECORD


For Public Land Survey Corners In:

WI ADMINISTRATIVE CODE A-E 7.08 REQUIREMENT

REV 10/23/2004 USMONREC.DWG

T. $\frac{4}{N}$. R. $\frac{10}{E}$. 4th P.M.

CORNER CODE INDEX

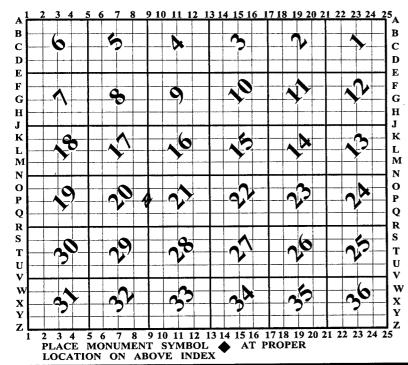

UNION TWP

IF AVAILABLE ROCK COUNTY COORDINATES PERFERRED

North	Elev
East	
Hor. Datum	Vert. Datum
LATITUDE	ELLIPS. HT
LONGITUDE	
NAD83(91)	NETWORK ADJ. YR 2010
GPS (X)	TRAVERSE (X)X_
BASED ON T	HE FOLLOWING CONTROL:

◆ CORNER MONUMENT

WITNESS MONUMENT

FIELD BOOK _____ PAGE # _____ OF \$\frac{3}{2}\$
OR OBSERVATION SHEET ____ OF \$\frac{3}{2}\$
SHOW A PLAN VIEW DRAWING DEPICTING THE CORNER MONUMENT AND SURROUNDING PHYSICAL FEATURES, INCLUDING THE EXCAVATION AREA AND DEPTH.
PLANNING & ZONING COMMITTEE ADOPTED THIS FORM ON 12/2/1982

CORNER CODE <u>P-7</u>

UN576 E1/4CORSEC20

(B) Describe any record evidence, monument evidence, occupational evidence, testimonial evidence or any other material evidence you considered, and whether the monument was found or placed.

- 1833 HARRISON T4N R1DE 4TH MER NORTH BET. SECS 20 & 21 1383.36? ASPEN 12
 - 2280.96 BROOK 9.24' CRS SE & ENTER PRAIRIE 330' SE MITCHE'S TRADING HOUSE.
 - 2640.00 QUARTER SEC COR. SET POST & RAISED MOUND
 - 4950.00 LEAVE PRAIRIE & ENTER TIMBER
 - 5280.00 COR TO SECS 16,17,20,21 {BURR 0 10 N41E 64.68'; BURR 0 12 S22E 121.44'; BURR 0 18 S44W 27.72'; BURR 0AK 12 N38W 116.16' LAND LEVEL & WET 2ND RATE TIMBER BURR 0 & RED 0. UNDERGROWTH SCRUBS, GRASS & WEEDS.
- 1857 CHURCH VOL 1 PG 70 GOV POST NOT FD. DIVIDED
 DISTANCES MARKED STAKE STUCK IT IN THE MARSH. NO
 BEARING. VAR 7-30 2646.60 TO NW COR SEC 21 & VAR 8
 2647.26 TO N 1/4 COR SEC 21. USED TO SUBDIVIDE SEC 21
- 1870 RUGER AUG 29 REMON-95 SOUTH ON EAST LINE OF NE 1/4 SEC 20 ON A VAR 6-22; OFFSET EAST 7.26' AT
 - 2645.94 INTERSECTED QUARTER LINE 5.94' WEST OF
 QUARTER CORNER. FOUND OLD STAKE AT
 CORNER. COR VAR 6-39 AUGUST 29,1870
 SOUTH ON EAST LINE OF SE 1/4 SEC 20
 ON A VAR 6-22; OFFSET WEST 5.94'
 OFFSET EAST 4.29' OFFSET WEST 4.29' AT
 - 2641.98 INTERSECTED SOUTH BOUNDARY LINE 6.73' WEST OF CORNER. COR VAR 7-42
- 1891 BLEEDORN VOL 2 PG 459 MON. USED TO SUBDIVIDE SEC 20. VAR5-25 2645.28 TO CENTER OF SEC 20, 2664.09 TO NE COR SEC 20, & 2647.92 TO MON @ SE COR SEC 20
- 1893 BLEEDORN VOL 2 PG 431 USED TO SUBDIVIDE SEC 21.
 STATES NOTHING ABOUT MON
- 1899 BROWN VOL 2 PG 512 MON. USED FOR SURVEY IN SEC 21. [EASTERLY] 925.98 TO RD OR R/R TRACKS
- 1982 COMBS CSM VOL 11 PG 152 SET PIPE
- 1984 COMBS CSM VOL 11 PG 540 ALUM MON
- BARNES P-9 DUG & FD POSSIBLE SMALL PIECES OF THE CUT LIMESTONE SCATTERED AROUND. USED RUGER'S 1870 REMONUMENTION DISTANCES FOR PRORATION TO CONTROL THE N/S LOCATION. THIS WAS IN HARMONY WITH THE E/W FENCE. RUGER SHOWS A VAR ON THE EAST LINE OF THE NE 1/4 & THE SE 1/4 OF SEC 20. THEREFORE I DID NOT SET THE CORNER ON LINE WITH THE NE & SE OF SEC 20. I USED BROWN'S RECORD DISTANCE TO THE CENTER OF THE ROAD TO CONTROL THE E/W LOCATION OF THE CORNER. THE DISTANCE TO THE N/S 1/4 LINE OF SEC 21IS 2669.05, WHICH IS IN HARMONY WITH BLEEDHORN'S RECORD DISTANCE OF 2669.04. SET POLY MON WITH CARSONITE POST.
- 1982 BARNES VOL 6 PG 288 S88-59-20W 2647.86 TO CENTER OF SEC 20, S88-59-20W 5285.37 TO W 1/4 COR SEC 20, S0-50-28E 2646.61 TO SW COR SEC 21, NO-05-35W 2650.58 TO NW COR SEC 21,
- 1982 BARNES N-9 2650.58 TO NE COR SEC 20

Dans 0 + 28 20/1

SHEET 1 OF 3 2

CORNER CODE P-9(1)

UN576 E1/4CORSEC20

FD POLY & REFERENCE MONUMENTS. USED 1982 FIELD OBSERVATIONS.

C) Was the corner restored through acceptance of (1) an obliterated evidence location, or, (2) a found perpetuated location?

ACCEPTED FD POLY MONUMENT WHICH PERPETUATES THE CUTLIMESTONE.

D) Describe any material discrepancy between the location of the corner as restored or reestablished and the location of that corner as previously restored or reestablished by distance and direction. Show the discrepancy on the plan view drawing under (a), above. Show the distances between the corner as previously restored or reestablished and (1) the corner as restored or reestablished, and (2) to at least 4 of the witness monuments shown on the drawing in (a), above.

NI

(E) Was the corner reestablished through lost corner proportionate methods? If so, show the method, including the directions and distances to other public land survey corners used as evidence or used for proportioning the corner location.

NO

I, **Donald Barnes**, hereby certify that the corner location as identified by the corner code index was determined by me under my direction and control and that this U.S. Public Land Survey Monument Record is correct and complete to the best of my knowledge and belief.

SHEET 2 OF 2

Emboss Oct 28, 2011

CORNER CODE P-9(1)

A.E. 7.08 REQUIREMENT