Paper weight-110# (minimum)


Black nonfading ink required

#### LAND **SURVEY** U.S. **PUBLIC** MONUMENT RECORD

WI ADMINISTRATIVE CODE A-E 7.08 REQUIREMENT Public Land Survey Corners In:

T.  $\frac{4}{N}$  N. R.  $\frac{10}{E}$  4th P.M.

CORNER CODE INDEX

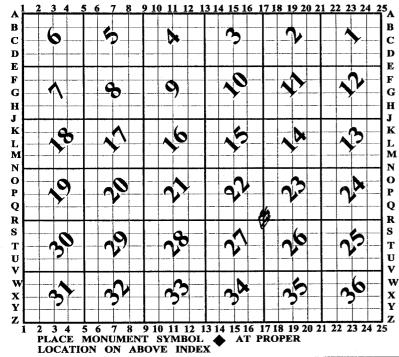

**UNION TWP ROCK COUNTY WI** 

IF AVAILABLE ROCK COUNTY COORDINATES PERFERRED

North	Elev.
East	
Hor. Datum	Vert. Datum
LATITUDE _	ELLIPS. HT.
LONGITUDE _	
NAD83(91)	NETWORK ADJ. YR 2010
GPS (X)	TRAVERSE (X) X
BASED ON THE	E FOLLOWING CONTROL:

**♦ CORNER MONUMENT** 

WITNESS MONUMENT

(a) ROCK COUNTY PROJECTION BEARINGS ARE BASED ON:\_

#### NECORSEC27

(B) Describe any record evidence, monument evidence, occupational evidence, testimonial evidence or any other material evidence you considered, and whether the monument was found or placed.

1833 HARRISON (NOV5) T4N R10E EAST ON RAND 23 & 26

2640.00 TEMPY 1/4 SEC COR. 5247.00 INT. E BDY 2.64' N OI INT. E BDY 2.64' N OF P LAND ROLLING 2ND RATE TIMBER W. & BURR D. ??? GRASS & WEEDS

WEST COR WEST BET SEC 23 & 26

2623.50 QUARTER SEC COR. (BYRR | 18 S16E 26.4' BURR 0 18 N83E 42.24 BURR 0 18 & BURR 0 18}MARKED

5247.00 SEC OR.

T4N R1DE 4TH MER NORTH BETWEEN SECS 26 1833 HARRISON & 27

> CREEK 13.2' CRS S.E. 739.2

2046.0 LEFT WET PRAIRIE

2640.00 QUARTER SEC CORNER (BURR O 20 N27E 13.86; BURR O 10 S62E 67.32 BURR O 20 & BURR O 10 MARKED

COR TO SECS 22,23,26,27 {BURR O 10 N4E 5280 57.42'; BURR O 8 S80E 31.68'; BURR O. 10 57E 44.88'; BURR 0 10 N62W 55.44' LAND SOUTH 1/2 LEVEL OF MILE 3RD RATE NORTH 1/2 ROLLING 2ND RATE TIMBER ALL BURR O. MOSTLY GRASS & WEEDS.

1833 HARRISON T4N R10E 4TH MER EAST BET. SECS 22 & 27

828.96 C? CREEK CRS SE

2640.00 TEMPY 1/4 SEC COR

5214.00 INT. E BDY 33.0 N OF P LAND & SAME

WEST COR WEST BET 22 & 27

2607.00 QUARTER SEC COR (WO 36 519E 29.04'; WO 29 N45W 50.16' WO 36 & WO 29 MARKED

5214.00 SEC COR

T4N R1DE 4TH MER NORTH BETWEEN SECS 22 1833 HARRISON & 23

2640.00 QUARTER SEC COR {BURR 0 12 S60W 25.74'; BURR 0 18 N64W 64.68 BURR 0 12 & BURR 0 12}MARKED

4062.96 BURR 0 18

COR TO SECS 14,15,22,23 (BURR O 12 S23W 5280.00 36.3'; BURR O 10 N20E 24.42' 24.42'; BURR □ 1□ N5□W 17.16'; BURR □ 12 S65E 14.52' LAND ROLLING 2ND RATE TIMBER ALL BURR O. MOSTLY GRUBS, GRASS & WEEDS

REMON-68 SOUTH ON WEST LINE OF NW 1/4 1870 RUGER AUG SEC 26 ON A VAR 8-00 AT

2662.52 INTERSECTED QUARTER LINE 9.9' EAST OF QUARTER COR. COR VAR 7-47 AUGUST 19 1870

> SOUTH ON WEST LINE OF SW 1/4 SEC 26 ON A VAR 7-55 OFFSET EAST 12.71' AT

2654.52 INTERSECTED SOUTH BOUNDARY LINE 13.04' EAST OF CORNER.

REMON-67 WEST ON NORTH LINE OF NE 1/4 1870 RUGER AUG SEC 26 ON A VAR 6-40 AT

INTERSECTED QUARTER LINE 22.44' NORTH OF 2647.26 QUARTER CORNER. FOUND STAKE AND STONE ON CORNER. ALSO FOUND STUMPS OF BOTH BEARING TREES. COR VAR 7-09

WEST ON NORTH LINE OF NW 1/4 SEC 26 ON A VAR 6-58 OFFSET NORTH 15.18' OFFSET SOUTH 33' AT

2650.56 INTERSECTED WEST BOUNDARY LINE 11.22'

SHEET 1 OF 3

CORNER CODE R-17(3)

10 cT 27,2011

SOUTH OF CORNER FOUND REMAINS OF OLD STAKE ALSO FOUND SOUTH BEARING TREE AND REMAINS OF STUMP OF NORTH BEARING TREE COR. VAR 7-07

- 1870 RUGER AUG REMON-98 AUGUST 30, 1870 WEST ON NORTH LINE OF NE 1/4 SEC 27 ON A VAR 7-00'; OFFSET NORTH 14.52' AT
  - 2616.90 INTERSECTED QUARTER LINE 19.14' NORTH OF QUARTER CORNER. FOUND STAKE SURROUNDED BY HARD HEAD STONES SET BY LOCKE AT CORNER. ALSO FOUND STUMBS OF BEARING TREES. TESTED STAKE AND FOUND IT CORRECT. COR VAR 7-06'

WEST ON NORTH LINE OF NW 1/4 SEC 27 ON A VAR 7-00 AT

- 2632.08 INTERSECTED WET BOUNDARY LINE 6.6' NORTH CORNER. COR VAR 7-09
- 1870 RUGER AUG REMON-97 SOUTH ON WEST LINE OF NW 1/4 SEC 23 ON A VAR 6-47 AT
  - 2643.30 INTERSECTED QUARTER LINE 6.60' EAST OF QUARTER CORNER. ESTABLISHED QUARTER CORNER FROM STUMP OF BEARING TREE. COR VAR 6-38

SOUTH ON WEST LINE OF SW 1/4 SEC 23 ON A VAR 6-55; AT

2649.90 INTERSECTED SOUTH BOUNDARY LINE AT CORNER.

- 1875 RUGER VOL 2 PG 201 STONE MON. VAR6-05 2650.56 STONE MON @ S 1/4 COR SEC 23, VAR5-54 2651.88 TO STONE MON @ W 1/4 COR SEC 23
- 1882 RUGER VOL 2 PG 398 STATES NOTHING ABOUT MON. VAR 6-00 2663.10 TO E 1/4 COR SEC 27
- 1883 RUGER VOL 2 PG 397 STATES NOTHING ABOUT MON. 2652.41 TO N 1/4 COR SEC 26
- 1907 KERCH VOL 3 PG 43 MON. 2655.1 TO MON @ N 1/4 COR SEC 26 & 2567.4 TO MON @ W 1/4 COR SEC 26. USED TO SUBDIVIDE NW 1/4 SEC 26
- 1928 PARSONS BK-10 PG 49 ASSESSORS PLAT SHEET 5 OF 7. STATES NOTHING ABOUT MON.
- 1938 SUNNY #5175 STONE MON @ THE SW COR OF SEC 23, T4N R10E NORTH 4-04 396.1 TO POB A IRON PIPE. NORTH ARROW CALLS FOR MAGNETIC MERIDAN
- 1938 SUNNY VOL 3 PG 389 FD STONE MON. N4-00W 2655.7 TO FD STONE @ W 1/4 COR SEC 23. STONE IS 16.5 EAST OF N/S FENCE & 43 WEST OF N/S FENCE. PLACED SEVERAL PIPES ALONG SEC LINE.
- 1938 SUNNY VOL 3 PG 405 FD STONE MON GRADED OUT BY C.H. DEPT. IN 1929. RESET SAID MON BY PROPORTIONATE MEASUREMENTS. MON 43 FROM E FENCE & 16 1/2 FROM W FENCE. SEE PG389. 2657 TO S 1/4 COR SEC 23, 2623.2 S 1/4 COR SEC 22, 2668.4 TO W 1/4 COR SEC 26, & 2655.7 TO W 1/4 COR SEC 23
- 1939 SUNNY #5174 STONE MON @ THE SW COR OF SEC 23, T4N R1OE 1' NORTH OF E/W FENCE ON EAST SIDE OF RD. N4-OOW 313.6X TO POB A PIPE. NORTH ARROW CALLS FOR MAGNETIC MERIDAN
- 1977 BARNES VOL 5 PG 236 FD CUT LIMESTONE 3.5 WEST OF WEST PVMT EDGE & 16 NORTH OF E/W FENCE LINE. REF. SAME.
- 1977 WOODMAN BK-29 PG 12 "GOLF ESTATES" FD R/R SPIKE
- 1977 WOODMAN CSM VOL 7 PG 5 FD R/R SPIKE
- 1982 COMBS CSM VOL 11 PG 21 STONE

SHEET 2 OF 3
CORNER CODE R-17(3)

On 1 27, 2011

- UN589 NECORSEC27
- BARNES R-17 FD CUT LIMESTONE & REF SAME. 2.5 WEST 1985 OF WEST PVMT EDGE. FB#2 PG 7 287,875.71; 2,19,800.37 **ELEV 922**
- BARNES VOL 6 PG 337 NO-27-33W 2655.90 TO E 1/4 COR 1985 SEC 22, S88-46W 2619.XX TO N 1/4 COR SEC 27, S1-25-19E 1334.79 TO 1/16TH COR., & 2668.63 TO E 1/4 COR SEC
- SCHNEEBERGER SUB #1421 ASSESSORS PLAT-EVANSVILLE 1990 SHEET 5 CONC. FD. S89-46-29W 2619.70 TO CONC. @ N 1/4 COR SEC 27
- 2000 BARNES VOL 6 PG 456 307,372.40; 421,711.86. FD LS. N89-35-06W 2619.79 TO S 1/4 COR EC 22, & NO-10-25E 2655.82 TO FD PK/TIES @ E 1/4 COR SEC 22
- 2000 BARNES R-17(1) FD CARSONITE POST, CUT LIMESTONE 0.9 DEEP WITH TOP PARTIALLY BROKE OFF & PIPE 2.01' TO THE WEST. PLACED MAGNETS 1.6' DEEP ON SE SIDE OF STONE. REFERENCED SAME. 2.5 WEST OF WEST PVMT EDGE.
- 2003 WIDOT BARNES R-17(2) INFORMATION FROM WIDOT PROJ 5155-00-22 SHEET 4.3 DATED 4-10-2003 CUT LIMESTONE 307,372.59; 421,711.70 E/W S0-47-10E 2668.75 TO E 1/4 COR SEC 27
- DOT USH 14 #25086 2003
- WIDOT USH 14 PROJ 5155-00-22 SHEET 4.3 FD CUT 2003 STONE. 307,372.59; 421,711.70 S0-47-10E 2668.75 T0 PK @ E 1/4 COR SEC 27
- 2003 LATHROP CSM VOL 26 PG 85 FD PIPE 2668.55 TO FD PK @ W 1/4 COR SEC 26
- DOT USH 14 #25365 2004
- COMBS CSM VOL 27 PG 202 FD STONE 2668.50 TO PK @ E 2004 1/4 COR SEC 27
- COMBS CSM VOL 28 PG 138 FD STONE 2668.45 TO PK @ E 2005 1/4 COR SEC 27
- COMBS CSM VOL 28 PG 183 STONE. 2668.45 TO PK @ E 2005 1/4 COR SEC 27
- DALSING P-32 PG 710 "CAPSTONE RIDGE" FD STONE @ N 2005 1/4 COR SEC 26.
- 2006 LATHROP SUB #14721 ASSESSORS PLAT SHEET 5. CUT STONE. SO-44-25E 2668.76 TO DRILL HOLE @ E 1/4 COR SEC 27
- LATHROP CSM VOL 30 PG 240 FD STONE 2668.76 TO FD 2006 SURVEY SPIKE @ E 1/4 COR SEC 27
- DALSING CSM VOL 32 PG 262 FD STONES @ NW & N 1/4 2008 COR SEC 26. 2656.97 BETWEEN CORNERS.
- LATHROP CSM VOL 32 PG 288 STONE 2668.55 TO PK @ W 2008 1/4 COR SEC 27

# FD CUT LIMESTONE & REFERENCE MONUMENTS.

C) Was the corner restored through acceptance of (1) an obliterated evidence location, or, (2) a found perpetuated location?

### ACCEPTED FD CUT LIMESTONE.

D) Describe any material discrepancy between the location of the corner as restored or reestablished and the location of that corner as previously restored or reestablished by distance and direction. Show the discrepancy on the plan view drawing under (a), above. Show the distances between the corner as previously restored or reestablished and (1) the corner as restored or reestablished, and (2) to at least 4 of the witness monuments shown on the drawing in (a), above.

# FD PIPE TO WEST OF L.S.

- (E) Was the corner reestablished through lost corner proportionate methods? If so, show the method, including the directions and distances to other public land survey corners used as evidence or used for proportioning the corner location. No
- I, **Donald Barnes**, hereby certify that the corner location as identified by the corner code index was determined by me under my direction and control and that this U.S. Public Land Survey Monument Record is correct and complete to the best of my knowledge and belief.

SHEET 3 OF 3

CORNER CODE R-17(3)

Oct 27, 2011 A.E. 7.08 REQUIREMENT