Paper weight-110# (minimum)

## Black nonfading ink required LAND SUI U.S. **PUBLIC** SURVEY MONUMENT RECORD


For Public Land Survey Corners In:

WI ADMINISTRATIVE CODE A-E 7.08 REQUIREMENT

REV 10/23/2004 USMONREC.DWG

T.  $\frac{4}{N}$  N. R.  $\frac{10}{E}$  4th P.M.

CORNER CODE INDEX

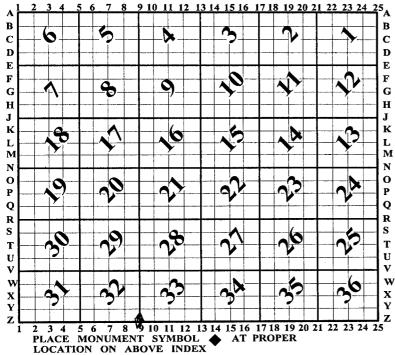

UNION ROCK COUNTY WI

IF AVAILABLE ROCK COUNTY COORDINATES PERFERRED

Elev. North East Hor. Datum \_\_\_\_ Vert. Datum LATITUDE ELLIPS. HT. LONGITUDE NAD83(91) \_\_\_\_\_NETWORK ADJ. YR 2010 GPS (X) \_\_\_\_ TRAVERSE (X) \_X

BASED ON THE FOLLOWING CONTROL:

**◆ CORNER MONUMENT** 

O WITNESS MONUMENT

1	PL
	I.C
(a)	
ROCK COUNTY PROJECTION	
ON:	
ARE BASED ON:	
j	ARE
	BEARINGS

PAGE # FIELD BOOK . SHEET OR OBSERVATION SHEET SHOW A PLAN VIEW DRAWING DEPICTING THE CORNER MONUMENT AND SURROUNDING PHYSICAL FEATURES, INCLUDING THE EXCAVATION AREA AND DEPTH. PLANNING & ZONING COMMITTEE ADOPTED THIS FORM ON 12/2/1982

CORNER CODE  $\frac{2}{2}$ 

## UN625 SECORSEC32

(B) Describe any record evidence, monument evidence, occupational evidence, testimonial evidence or any other material evidence you considered, and whether the monument was found or placed.

1833 BRINK & MULLETT (SEP 12) T4N R10E

WEST ON SOUTH SIDE OF SECTION 33 (PG109)

241.56 B. DAK 5

2640.00 SET QUARTER SECTION POST B. OAK 18 N53W 81.84'; B. OAK 6 N66 1/2E 128.7'

3234. STREAM 2.64 CROSS SOUTH

4620 ENTER PRAIRIE

5280.00 SET POST FOR CORNER TO SECTION 32 & 33 IN PRAIRIE MADE A SQUARE MOUN OF EARTH AND SODS 3 FEET HIGH & 3 FEET DIAMETER AT THE BASE. LAND EAST OF PRAIRIE ROLLING SECOND RATE TO TIMBER BURR AND B. OAK HAZLE RED ROOT CROSSES PRAIRIE LEVEL & RICH FIRST RATE COVERED WITH GRASS

1833 BRINK & MULLETT (SEP 12) T4N R10E

WEST ON SOUTH SIDE OF SECTION 32 (PG110)

2640.00 SET QUARTER SECTION POST B OAK 18 N49 1/2W 197.34'; B. OAK 16 N15 1/2W 229.02'

2838 LEAVE PRAIRIE

5280.00 SET POST FOR CORNER TO SECTIONS 31 & 32. W/
PAL 16 N39E 38.94'; BURR OAK 18 N41W 82.5'
FIRST HALF LEVEL RICH PRAIRIE RED ROOT ROSE
WILLOW GRASS & C WESTERN HALF ROLLING
SECOND RATE BURR B & W OAK HAZLE RED ROOT
& C.

1833 HARRISON T4N R1DE NORTH BET SECS 32 & 33

528.0 ENTER TIMBER

2640.00 QUARTER SEC COR. {W.O. 14 N80E 68.64'; W.O. 24 S70W 91.08' WO 14 & WO 24}MARKED

3300 ENTER MARSH CRS E & W

5280.00 LEAVE IT AND SET COR TO SECS 28,29,22,&33 {BURR 0 14 N18E 48.84'; BURR 0 12 N54W 51.48'; BURR 0 12 S80W 66.00'; BURR 0 12 S20E 13.86' LAND 1ST 1/2 MILE ROLLING 2ND RATE WITH BURR & W.O. TIMBER UNDERGROWTH SCRUBS GRASS & WEEDS.

1833 HARRISON (DEC 6) T3N R10E 4 TH MER. NORTH BET. SECS 4 & 5

2640.00 HALF MILE POST {RED 0 8 N38W 41.58 BUR 0 14 S5W 28.38 RED 0 8; BURR 0 14}

4455.00 ENTER WET PRAIRE

4835.82 INT. N. BDY 173.58' W OF P. BUR O 12 S34W ???' LAND ROLLING 2ND RATE TIMB. BURR O.

1846 BENSON MAGNOLIA TOWN RD RECORDS BK 1 PG 1 NOTICE OF A SURVEY OF A ROAD LEADING FROM BELOIT ROCK COUNTY, WISCONSIN TERRITORY TO EXETER IN GREEN COUNTY, WISCONSIN. COMMENCING AT THE TOWN LINE 877.80' WEST OF THE 1/4 POST ON THE NORTH SIDE OF SEC 6 T2 RANGE 10 E RUNNING N18W 1188'; THENCE N21-30W 990'; THENCE N18W 1188'; THENCE N34-15W 2574' THENCE NORTH 17-15? 726'; N21-30W 990' TO THE COUNTY LINE HIRAM BROWN, ELISA MC MONTH COMMISSIONERS APPOINTED BY THE ACT OF LEGISLATURE 1945 OF THE ACT TO AUTHORIZE THE LOCATION OF CERTAIN TERRITORY ROADS. I DO HEREBY CERTIFY THAT THE ABOVE MINUTES OF THE SURVEY OF A ROAD FROM BELOIT TO EXETER, W.T. AS SURVEYED BY ME. HENRY A. BENSON, SURVEYOR

1863 LOCKE VOL 1-172 FD OLD STAKE. SHOWS THAT CORNER IS 73.58 EAST OF THE NE COR OF SEC 5 & 5254.26 TO THE SW COR OF SEC 33

SHEET 1 OF 3

CORNER CODE Z-9(1)

Emboss Banos
0 cT 20,2011

## UN625 SECORSEC32

- LOCKE VOL 1 PG 183 FD OLD STAKE. 173.58 EAST OF COR BY FD REMAINS OF B TREE @ NE COR SEC 5. 5254.26 FROM SE TO SW COR OF SEC 32.
- LOCKE VOL 1 PG 196 CALLS FOR OLD STAKE 1863 STANDING IN INTERSECTION OF SOD FENCES, 173.58 EAST OF NW COR OF SEC 4, & 2619.54 TO THE SOUTH QUARTER COR OF SEC 33.
- RUGER AUG REMON-80 EAST ON SOUTH LINE OF SW 1/4 1870 SEC 32 ON A VAR 7-10 AT
  - 2628.12 INTERSECTED QUARTER LINE 3.3' NORTH OF QUARTER CORNER. FOUND OLD STAKE ON CORNER. ALSO FOUND STUMPS OF BOTH BEARING TREES. COR VAR 7-06

EAST ON SOUTH LINE OF SE 1/4 SEC 32 ON A VAR 6-30 OFFSET SOUTH 3.63' AT

- 2629.11 INTERSECTED EAST BOUNDARY LINE 8.58 SOUTH OF CORNER FOUND OLD STAKE AT CORNER. COR VAR 6-36
- REMON-81 EAST ON SOUTH LINE OF SW 1/4 1870 RUGER AUG SEC 33 ON A VAR 6-57 OFFSET SOUTH 14.02' AT
  - 2623.00 INTERSECTED QUARTER LINE 15.84 SOUTH OF QUARTER CORNER. FOUND STUMP OF SOUTH BEARING TREE AND REMAINS OF STUMP OF NORTH BEARING TREE. COR VAR 7-00'

EAST ON SOUTH LINE OF SE 1/4 SEC 33 DN A VAR 7-45 AT

- 2626.80 INTERSECTED EAST BOUNDARY LINE AT CORNER. RUGER AUG REMON-81 NORTH ON WEST LINE OF SW 1/4 1870 SEC 33 ON A VAR 6-45 OFFSET WEST 12.21'AT
  - 2655.18 INTERSECTED QUARTER LINE 11.22' WEST OF QUARTER CORNER. FOUND OLD STAKE SURROUNDED BY HAR HEAD STONES AT CORNER. ALSO FOUND STUMP OF WEST BEARING TREE AND WHERE STUMP OF EAST BEARING TREE HAD BEEN DUG UP. COR VAR 6-46

NORTH ON WEST LINE OF NW 1/4 SEC 33 ON A VAR 7-07 OFFSET WEST 16.5' WEST 4.62' DFFSET WEST 38.61' AT

2658.48 INTERSECTED NORTH BOUNDARY LINE 44.88 WEST OF CORNER. COR VAR 7-27

- BLEEDORN VOL 2-457 CALLS FOR A MON. 1891
- BARNES VOL 6 PG 421 FD LS. N89-21-58W 173.58 TO 1991 PLACED POLY @ NW COR SEC 4. S89-06-25E 2631.91 TO LS @ S 1/4 COR SEC 33 & NO-36-18E 2655.18 TO FD PK @ W 1/4 COR SEC 33.
- BARNES Z-9 FD CUT LIMESTONE 2.6' LONG LEANING TO 1991 THE NORTH WEST & TOP IN BOTTOM OF HOLE. FD BASE OF LIMESTONE. PLACED 26" LONG CAST IRON MONUMENT ON TOP OF STONE & CARSONITE POST NEXT TO CI. REFERENCED SAME.
- BARNES A-9 @ SW COR SEC 33 FD CUT LIMESTONE 2.6' 1991 LONG LEANING TO THE NORTH WEST & TOP IN BOTTOM OF HOLE. FD BASE OF LIMESTONE. PLACED 26" LONG CAST IRON MONUMENT ON TOP OF STONE & CARSONITE POST NEXT TO CI. REFERENCED SAME. @ NE COR SEC 5 DUG A SMALL HOLE & FD NOTHING. SET POLY. MON /CARSONITE ON LINE WITH THE SE COR & THE S 1/4 COR SEC 32 AT RECORD DISTANCE. 173.58 BETWEEN SEC CORNERS.

SHEET 2 OF 3

CORNER CODE Z-9(1)

Ourld Baines Oct 20, 2011

BEAL

## UN625 SECORSEC32

- 1992 COMBS #11193 STATES NOTHING ABOUT MON. NORTH 939.10 TO POB.
- 1992 COMBS #9982 STATES NOTHING ABOUT MON. NORTH 1029.10 TO POB.
- 1995 KARNS CSM VOL 18 PG 197 FD ALUM @ NE COR SEC 5. S89-49-15W 2459.15 TO ALUM @ S 1/4 COR SEC 32.
- 1995 KARNS CSM VOL 18 PG 198 FD ALUM @ NE COR SEC 5. 2459.15 TO ALUM @ S 1/4 COR SEC 32.
- 2005 COMBS #15128 NE COR SEC 5 T3R10E FD ALUM. MON. 2459.15 FROM ALUM @ S 1/4 COR SEC 32 TO NE COR SEC 5.

FD CI. & REFERENCE MONUMENTS. USED MY OLD OBSERVATIONS TO COMPUTE COORDINATES & TRAVERSE ADJUSTMENT.

C) Was the corner restored through acceptance of (1) an obliterated evidence location, or, (2) a found perpetuated location?

ACCEPTED FD CI.

Putos ( Stores 0 17 20, 2611

- D) Describe any material discrepancy between the location of the corner as restored or reestablished and the location of that corner as previously restored or reestablished by distance and direction. Show the discrepancy on the plan view drawing under (a), above. Show the distances between the corner as previously restored or reestablished and (1) the corner as restored or reestablished, and (2) to at least 4 of the witness monuments shown on the drawing in (a), above.
- (E) Was the corner reestablished through lost corner proportionate methods? If so, show the method, including the directions and distances to other public land survey corners used as evidence or used for proportioning the corner location.
- I, **Donald Barnes**, hereby certify that the corner location as identified by the corner code index was determined by me under my direction and control and that this U.S. Public Land Survey Monument Record is correct and complete to the best of my knowledge and belief.

SHEET 3 OF 3

CORNER CODE Z-9(1)

A.E. 7.08 REQUIREMENT