Paper weight-110# (minimum)

Black nonfading ink required

## Black nonface LAND U.S. PUBLIC SURVEY MONUMENT RECORD


For Public Land Survey Corners In:

WI ADMINISTRATIVE CODE A-E 7.08 REQUIREMENT

REV 10/23/2004 USMONREC.DWG

T. 4 N. R. 10 E. 4th P.M.

CORNER CODE INDEX

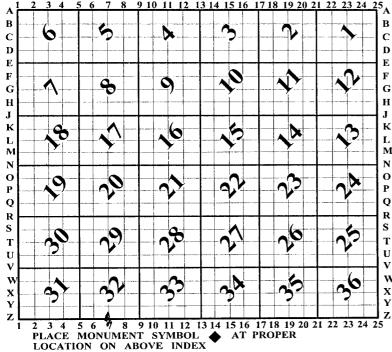

## **UNION** TWP **ROCK COUNTY WI**

IF AVAILABLE ROCK COUNTY COORDINATES PERFERRED

North	Elev.
East	-
Hor. Datum _	Vert. Datum
LATITUDE	ELLIPS. HT
LONGITUDE	
NAD83(91)	NETWORK ADJ. YR 2010
GPS (X)	TRAVERSE (X) X
BASED ON TH	HE FOLLOWING CONTROL:

**◆ CORNER MONUMENT** 

O WITNESS MONUMENT

,	<u> </u>	2 PL
	(a)	)
	ROCK COUNTY PROJECTION	N:NC
	,	z O
		S ARE BASED ON
	,	BEARINGS

FIELD BOOK PAGE #		/	5
OR OBSERVATION SHEET			OF
SHOW A PLAN VIEW DRAWING DEPICTING THE CORNER MONUMENT AND	SURROUND	ING	
PHYSICAL FEATURES, INCLUDING THE EXCAVATION AREA AND DEPTH.			
PLANNING & ZONING COMMITTEE ADOPTED THIS FORM ON 12/2/1982			

## UN624 S1/4CORSEC32

(B) Describe any record evidence, monument evidence, occupational evidence, testimonial evidence or any other material evidence you considered, and whether the monument was found or placed.

1833 BRINK & MULLETT (SEP 12) T4N R10E

WEST ON SOUTH SIDE OF SECTION 32 (PG110)

2640.00 SET QUARTER SECTION POST B OAK 18 N49 1/2W 197.34'; B. OAK 16 N15 1/2W 229.02'

2838 LEAVE PRAIRIE

5280.00 SET POST FOR CORNER TO SECTIONS 31 & 32. W/PAL 16 N39E 38.94'; BURR OAK 18 N41W 82.5'
FIRST HALF LEVEL RICH PRAIRIE RED ROOT ROSE
WILLOW GRASS & C WESTERN HALF ROLLING
SECOND RATE BURR B & W OAK HAZLE RED ROOT
& C.

- 1849 COTTER, CAIN, & PARTRIDGE MAGNOLIA TWP RD REC BK 1 PG 9 A PUBLIC HIGHWAY OF THE WIDTH OF FOUR RODS COMMENCINT AT A STAKE 1056' EAST OF THE QUARTER STAKE ON THE NORTH SIDE OF SECTION FIVE ON THE TOWN LINE BETWEEN UNION & MAGNOLIA RUNNING S42 1/2E 1353' TO A STAKE THEN S39 1/2E 1544.4' TO A STAKE; THENCE S42E 2281.62'; THENCE S2 1/2W 871.2' TO THE TERMINATION FROM WHICH THE NE CORNER OF NORTONS MILL BEARS S34W 9240' AND SAID NORTONS MILL BEARS N69 3/4E 146.52 SAID COURSES AND DISTANCES TO BE THE CENTER OF THE ROAD.
- MAGNOLIA TWP RD REC BK 1 PG 25 """ WHEREOF AN 1859 ACCURATE SURVEY HAS BEEN MADE WHICH IS AS FOLLOWS TO WIT. COMMENCING AT THE QUARTER STAKE ON THE SOUTH LINE DIVIDING SEC 32 OF UNION & SECTION FIVE IN MAGNOLIA AND RUNNING THENCE WEST ALONG SAID LINE TO THE SOUTH CENTER QUARTER POST OF SECTION 31 OF SAID TOWN OF UNION AND SECTION 6 OF MAGNOLIA THE LINE OF SAID SURVEY TO BE THE CENTER OF SAID HIGHWAY THENCE WEST ON THE LINE OF SAID SECTION 31 IN THE TOWN OF UNION AND SECTION SIX OF MAGNOLIA TO THE WEST LINE O FTHE EAST HALF OF THE NW 1/4 OF SECTION SIX IN THE TOWN OF MAGNOLIA, LINE OF SAID SURVEY TO BE THE NORTH LINE OF SAID HIGHWAY THENCE WEST ALONG THE LINE OF SECTION 31 AND SECTION 6 OF THE TOWN OF MAGNOLIA TO THE WEST SIDE OF SAID SECTION, THE LINE OF SAID SURVEY TO BE THE CENTER OF SAID HIGHWAY AND THE SAME IS HEREBY ESTABLISHED FOUR RODS WIDE.
- 1863 LOCKE VOL1-183 @ N 1/4 COR SEC 5 SET HH 20X18X10 & SMALL LIMESTONE ON N,S,E, & W. FD STONE SET AT THE S 1/4 COR SEC 32. USED TO SUBDIVIDE SEC 5. 2214.96 TO THE CENTER OF SEC 5. N 1/4 COR SEC 5 VAR 7-30 2665.08 TO FD REMAINS OF BT @ NE COR SEC 5 & N 1/4 COR SEC 5 VAR 7-45 2661.78 TO NW COR SEC 5.
- 1870 RUGER AUG REMON-80 EAST ON SOUTH LINE OF SW 1/4
  SEC 32 ON A VAR 7-10 AT
  - 2628.12 INTERSECTED QUARTER LINE 3.3' NORTH OF QUARTER CORNER. FOUND OLD STAKE ON CORNER. ALSO FOUND STUMPS OF BOTH BEARING TREES. COR VAR 7-06

EAST ON SOUTH LINE OF SE 1/4 SEC 32 ON A VAR 6-30 OFFSET SOUTH 3.63' AT

- 2629.11 INTERSECTED EAST BOUNDARY LINE 8.58 SOUTH OF CORNER FOUND OLD STAKE AT CORNER. COR VAR 6-36
- 1890 BLEEDORN VOL 2 PG 439 @ N 1/4 COR SEC 5 FD COR SET BY LOCKE. USED TO SUBDIVIDE SEC 5. VAR 5-13 2665.08 TO NW COR SEC 5

SHEET 1 OF 3

CORNER CODE Z-7

Dunes Oct 20,2071

- UN624 S1/4CORSEC32
- 1900 BROWN VOL 2-518 CALLS FOR A MON. USED TO SUBDIVIDE SEC 32. 2635.05 TO SW COR SEC 32, 1317.52 TO AN IRON ON THE SOUTH LINE OF THE SW 1/4 OF SEC 32
- 1968 BATTERMAN VOL 4-364 N 1/4 COR SEC 5. FD STONE 20X18X10 POINT UP 8" DEEP. REFERENCED SAME.
- 1968 BATTERMAN A-8 FB#142 PG 34 FD STONE 20X9X8 1 DEEP 1090.32 EAST OF N 1/4 COR SEC 5. REFERENCE STONE.
- 1968 BATTERMAN VOL 4-364 FD CUT LIMESTONE 1 1/2 DEEP. PLACED 16PD NAILS IN 3 UTILITY POLES.
- 1991 BARNES VOL 6 PG 421 FD LS S89-21-59E 2632.80 TO FD LS @ SE COR SEC 32, N89-52-08W 2631.01 TO R/R @ SW COR SEC 32. SHOWS IT AS EAST OF N 1/4 COR SEC 5
- 1991 BARNES Z-6 S 1/16TH COR SW 1/4 SEC 32 DID NOT FIND HE NW & NE REFERENCE PIPES. FD THE SE REF PIPE \*REC 0.16). ALSO FD THE OLD EXCAVATION PATCH. THE PK THAT PLACED IS 4.7' NORTH OF THE CENTER OF THE PAVEMENT. DUG 2.8' DEEP AT RECORD DISTANCE FROM THE FD REFERENCE PIPE. I STARTED AT THE SW COR OF THE PATCH & DUG A 2' WIDE HOLE UNTIL I WAS 2 NORTH OF THE CENTER OF THE PVMT & FD NOTHING. I DID NOT RESTORE COR. 1968 BATTERMAN VOL 4 PG 365 FD LIMESTONE 1.5' DEEP & REFERENCED.
- 1991 BARNES Z-7 BATTTERMAN TIES ARE GONE. DUG & FD CUT LIMESTONE 2.7 DEEP WITH TOP BROKEN OFF. CORNER IS ON LINE WITH CENTER OF PVMT TO THE NORTH & ON THE SOUTHE EDGE OF THE E/W PVMT. PLACED MAGNET NEXT TO STONE & POLY MON ON TOP. REFERENCED SAME.
- 1994 KRIZAN CSM VOL 17 PG 161 ALUM NO-13-50E 1319.84 TO 1/16TH COR. FROM 1/16TH COR N89-56-33W 1314.02 TO 1/16TH COR. NO-13-50E 5314.20 TO ALUM @ N 1/4 COR SEC 32
- 1994 BARNES A-7 @ N 1/4 COR SEC 5 COULD NOT FIND REFERENCE PIPES. FD OLD PATCH & LIMITS OF OLD EXCAVATION WAS CLEARLY DELINEATED. DUG 3' DEEP AND FD NOTHING. SET 3/424 REROD @ N 1/4 COR SEC 5. THIS CORNER WAS RESTORED THROUGH ACCEPTANCE OF AN OBLITERATED EVIDENCE LOCATION. MAINTAINED EQUAL DISTANCE BETWEEN THE NE & NW CORNERS OF SEC 5. ALSO MAINTAINED HARMONY WITH THE E/W FENCE LINE & THE P.P AS SHOWN IN VOL 4 PG 364
- 1995 LATHROP #9306 FD 3/4 IRON PIPE @ N 1/4 COR SEC 5 T3N R10E SO-01-06W 2228.84 TO FD LIMESTONE AT CENTER OF SEC 5 SET BY BLEEDORN IN 1890. FROM CENTER OF SEC 5 TO ALUM. MON @ W 1/4 COR SEC 5 IS N89-27-37W 2656.42 (BLEEDORN 2659.14) & S89-24-45E 2664.94 (BLEEDORN 2666.40) TO COMPUTED LOCATION OF E 1/4 COR SEC 5.
- 1995 KARNS CSM VOL 18 PG 197 ALUM. N89-46-15E 2459.15 TO ALUM @ NE COR SEC 15 & N87-19-52W 194.05 TO FD 3/4 REROD @ N 1/4 COR SEC 5
- 1995 KARNS CSM VOL 18 PG 198 N89-46-15E 2459.15 TO ALUM @ NE COR SEC 15 & N87-19-52W 194.05 TO FD 3/4 REROD @ N 1/4 COR SEC 5
- 2005 COMBS #15128 NE COR SEC 5 T3R10E FD ALUM. MON. 2459.15 FROM ALUM @ S 1/4 COR SEC 32 TO NE COR SEC 5.

1991 FD REFERENCE MONUMENTS. USED OLD OBSERVATIONS

SHEET 2 OF 3

Sittle Faires 0,720,2011

CORNER CODE Z-7

C) Was the corner restored through acceptance of (1) an obliterated evidence location, or, (2) a found perpetuated location?

ACCEPTED POLY MON., WHICH PERPETUATES THE CUT LIMESTONE.

D) Describe any material discrepancy between the location of the corner as restored or reestablished and the location of that corner as previously restored or reestablished by distance and direction. Show the discrepancy on the plan view drawing under (a), above. Show the distances between the corner as previously restored or reestablished and (1) the corner as restored or reestablished, and (2) to at least 4 of the witness monuments shown on the drawing in (a), above.

NONE

Baires Baires DITZO 2011

(E) Was the corner reestablished through lost corner proportionate methods? If so, show the method, including the directions and distances to other public land survey corners used as evidence or used for proportioning the corner location.

NΟ

I, **Donald Barnes**, hereby certify that the corner location as identified by the corner code index was determined by me under my direction and control and that this U.S. Public Land Survey Monument Record is correct and complete to the best of my knowledge and belief.

SHEET 3 OF 3

CORNER CODE **Z-7** 

A.E. 7.08 REQUIREMENT