

For Public Land Survey Corners in the T. H.N., R. 10 E.


## CORNER CODE INDEX

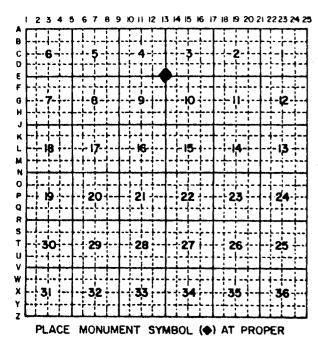

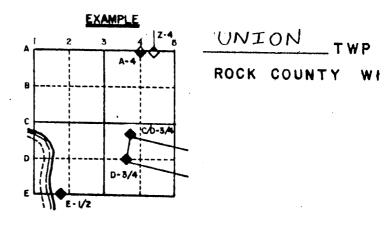

IF AVAILABLE STATE PLANE COORDINATES

North (Y)	Eleve. (Z)
East (X)	Zone
Hor. Datum	Vert. Datum

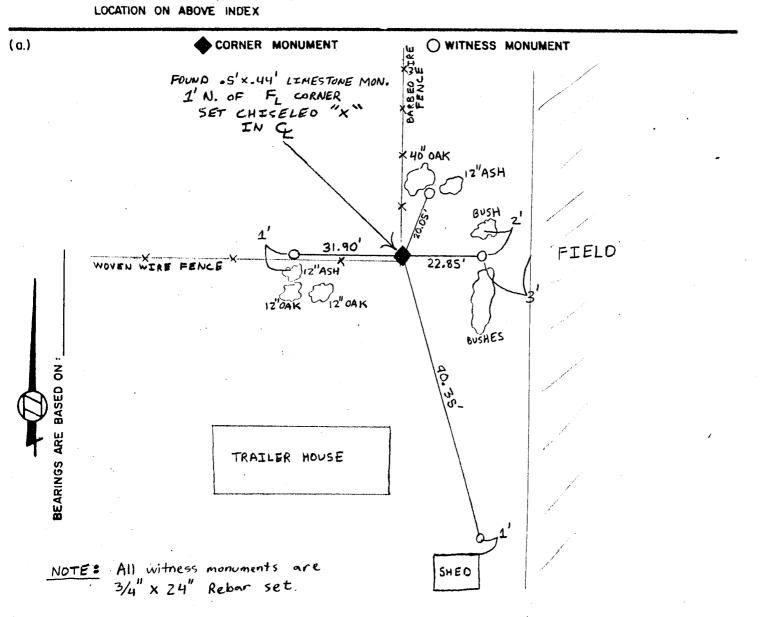

FIELD BOOK \_\_\_\_ PAGE #

SHOW A PLAN VIEW DRAWING DEPICTING THE CORNER MONUMENT AND SURROUNDING PHYSICAL FEATURES, INCLUDING THE EXCAVATION AREA AND DEPTH. THE CORNER MONUMENT SHALL HAVE THE FOLLOWING CHARACTERISTICS: I) HAVE AT LEAST TWO PREDETERMINED BREAK-OFF POINTS. 2) IF BROKEN, LEAVE A PERMANENTLY MAGNETIZED REMNANT AT THE ORIGINAL POINT. 3) MUST BE EXTENDABLE. 4) THE CAP IS INSCRIBED: ROCK COUNTY SURVEY MONUMENT - PENALTY FOR DISTURBING MARKER. 5) OR AN EXISTING CUT LIMESTONE. AN IRON PIPE IN A 10" (MINIMUM) MAY BE USED IN AREAS WHERE GHOUND WATER IS WITHIN ONE FOOT OF THE SURFACE. IF THE CORNER IS OCCUPIED BY AN IMPROVEMENT (MANHOLE, BURIED CABLE, ETC.) ANY DURABLE, DISTINCT MONUMENT MAY BE USED. CORNERS, SHALL BE REFERENCED WITH AT LEAST 4 DURABLE WITNESS MONUMENTS. WITNESS MONUMENTS SHALL BE MADE OF CONCRETE, NATURAL STONE, IRON OR OTHER EQUALLY DURABLE MATERIAL, EXCEPT WOOD. DESCRIBE THE CORNER AND THE WITNESS MONUMENTS.

E-013

( b.)	Describe any record evidence, monument evidence, occupational evidence, testimonial evidence or any other material evidence you considered, and whether the monument was found or placed.		
,	Found a limestone monument 1.0 food This monument agrees with Plat and	t north and <b>Q.5</b> feet east of fence corner. Record Volume 4, Page 532.	
	•		
		•	
(c.)	Was the corner restored through accepta found perpetuated location?	ince of (1) an obliterated evidence location, or, (2) a	
	A found perpetuated location.		
( d.)	Describe any material discrepancy between the location of the corner as restored or reestablished and the location of that corner as previously restored or reestablished by distance and direction. Show the discrepancy on the plan view drawing under (a), above. Show the distances between the corner as previously restored or reestablished and (1) the corner as restored or reestablished, and (2) to at least 4 of the witness monuments shown on the drawing in (a), above.		
	No known discrepancy.		
(e.)	Was the corner reestablished through lost corner proportionate methods? If so, show the method, including the directions and distances to other public land survey corners used as evidence or used for proportioning in determining the corner location.		
	No.		
	May 10, 1994, establishe recovered or restored as e regulations and rules as r	hereby certify that the corner points r code index were, in a field survey on d, re-established, monumented, re-monumented, xpressed below and in conformance with the equired in the current manual of survey States Department of Interior, Bureau	
	***************************************	COUNTY SURVEYOR FILING DATA	
		Date of Computer Entry	
	SAAL MARK TO THE SAAL	Date Bendand	
1	MARK T.  KRIZAN  S-1928  MADISON  WIS- 2-1-1-1-1-1-1-1-1-1-1-1-1-1-1-1-1-1-1-	Date Microfilmed	
,	S-1928 MADISON (	Treasurer's Receipt No.	
	WIR. D. WARE	Number of Included Sheets	
	SURVE SORESERVE	CORNER AFFIX YOUR LAND SURVEYOR SEAL. CODE <u>E-013</u>	
	SURVETOR SEAL.		