Paper weight-110# (minimum)

Black nonfading ink required

## U.S.


## LAND **SURVEY** PUBLIC MONUMENT RECORD

Public Land Survey Corners In:

WI ADMINISTRATIVE CODE A-E 7.08 REQUIREMENT

T. 4 N. R. 10 E. 4th P.M.

CORNER CODE INDEX

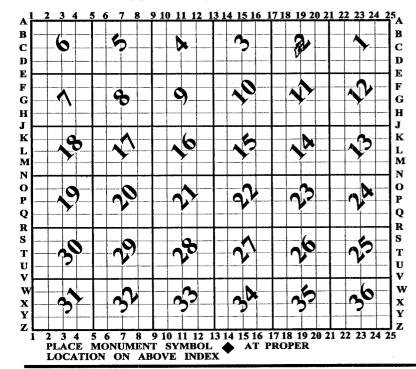

## **UNION TWP ROCK COUNTY WI**

IF AVAILABLE ROCK COUNTY COORDINATES PERFERRED

North	Elev.		
East			
Hor. Datum	Vert. Datum		
LATITUDE _	ELLIPS. HT.		
LONGITUDE _			
NAD83(91)	NETWORK ADJ. YR 2010		
GPS (X)	TRAVERSE (X) X		
BASED ON THI	E FOLLOWING CONTROL:		

**◆ CORNER MONUMENT** 

WITNESS MONUMENT

(a) ROCK COUNTY PROJECTION BEARINGS ARE BASED ON:\_

FIELD BOOK PAGE #		/ /	
OR OBSERVATION SHEET	SHEET		
SHOW A PLAN VIEW DRAWING DEPICTING THE CORNER MONUMENT AND SURROUNDING			
PHYSICAL FEATURES, INCLUDING THE EXCAVATION AREA AND DEPTH.			
PLANNING & ZONING COMMITTEE ADOPTED THIS FORM ON 12/2/1982	•	O(1)	
CODITION	CODE	1 -17	

CORNER CODE \_\_\_

## UN4518 CEN2

- (B) Describe any record evidence, monument evidence, occupational evidence, testimonial evidence or any other material evidence you considered, and whether the monument was found or placed.
- 1884 RUGER VOL 2 PG 387 SET HH 20X14X9 SURROUNDED BY 4 HH STONES. (NOTE: FD BY CO SURVY 6/7/71) 2613.60 TO STONE MON @ E 1/4 COR SEC 2, 2609.31 TO STONE MON @ W 1/4 COR SEC 2, VAR 5-48 2543.72 TO STONE MON @ N 1/4 COR SEC 2, & VAR 5-48 2665.74 TO FD STONE MON @ S 1/4 COR SEC 2
- 1971 LEE VOL 4 PG 525 DUG & FD HH 20X9X14 SURROUNDED BY 4 HH. SET 2X30" PIPE IN PLACE & PUT STONE ON S. SIDE. REFERENCED SAME.
- 1975 WILHELM #7008 FD 2" IP FROM COUNTY TIES
- 1975 WILHELM (BARNES) VOL 5 PG 161 FD 2" IP FROM COUNTY TIES.

FD 2" PIPE. 2' [REC 2.5] WEST OF A 8' LONG N/S FENCE LINE ON SOUTH SIDE OF E/W FENCE. 32.8' [REC 27'] WEST OF N/S FENCE ON NORTH SIDE OF E/W FENCE. PIPE IS UNDER E/W FENCE LINE.

C) Was the corner restored through acceptance of (1) an obliterated evidence location, or, (2) a found perpetuated location?

ACCEPTED FD PIPE

D) Describe any material discrepancy between the location of the corner as restored or reestablished and the location of that corner as previously restored or reestablished by distance and direction. Show the discrepancy on the plan view drawing under (a), above. Show the distances between the corner as previously restored or reestablished and (1) the corner as restored or reestablished, and (2) to at least 4 of the witness monuments shown on the drawing in (a), above.

NONE

(E) Was the corner reestablished through lost corner proportionate methods? If so, show the method, including the directions and distances to other public land survey corners used as evidence or used for proportioning the corner location.

NΟ

I, **Donald Barnes**, hereby certify that the corner location as identified by the corner code index was determined by me under my direction and control and that this U.S. Public Land Survey Monument Record is correct and complete to the best of my knowledge and belief.

SHEET 1 OF 1

Dec 30,2011

CORNER CODE C-19

A.E. 7.08 REQUIREMENT