Paper weight-110# (minimum)

Black nonfading ink required

## LAND **SURVEY** U.S. PUBLIC MONUMENT RECORD


For	Public	Land	Survey	Corners	In:	
	I WOIL	1.744114	Survey	COLIECTO		

WI ADMINISTRATIVE CODE A-E 7.08 REQUIREMENT

REV 10/23/2004

T. 4 N. R. 10 E. 4th P.M.

CORNER CODE INDEX

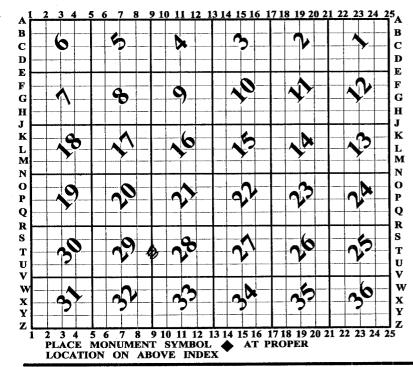

## **UNION TWP ROCK COUNTY WI**

IF AVAILABLE ROCK COUNTY COORDINATES PERFERRED

North	Elev		
East			
Hor. Datum	Vert. Datum		
LATITUDE	ELLIPS. HT.		
LONGITUDE _			
NAD83(91)	NETWORK ADJ. YR 2010		
GPS (X)	TRAVERSE (X) X		
BASED ON THE	FOLLOWING CONTROL:		

**♦ CORNER MONUMENT** 

WITNESS MONUMENT

(a) ROCK COUNTY PROJECTION BEARINGS ARE BASED ON:\_

FIELD BOOK PAGE # OR OBSERVATION SHEET	SHEET	OF	3
SHOW A PLAN VIEW DRAWING DEPICTING THE CORNER MONUMENT AND S PHYSICAL FEATURES, INCLUDING THE EXCAVATION AREA AND DEPTH.	URROUNDING		
PLANNING & ZONING COMMITTEE ADOPTED THIS FORM ON 12/2/1982	CODE	T-	9

## W1/4CORSEC28 UN596

(B) Describe any record evidence, monument evidence, occupational evidence, testimonial evidence or any other material evidence you considered, and whether the monument was found or placed.

- 1833 HARRISON T4N R10E 4TH MER NORTH BET. SECS 28 & 29 1555.62 WO 18
  - 2640.00 QUARTER SEC COR. (WO 12 S79E 24.42'; WO 18 W 12.54' WO 12 & WO 18 MARKED
  - 5280.00 COR TO SECS 20,21,28,29 {BURR O 10 S64E 273.24'; BURR O 12 S60W 234.96' LAND LEVEL 2ND RATE TIMBER BURR RED & W. O. UNDERGROWTH SCRUBS, GRASS, & WEEDS.
- 1870 RUGER AUG REMON-77 SOUTH ON WEST LINE OF NW 1/4 SEC 28 ON A VAR 7-05 OFFSET EAST 1.98' AT
  - 2665.41 INTERSECTED QUARTER LINE 5.94 EAST OF QUARTER CORNER. FOUND OLD STAKE AND BOTH STUMPS OF BEARING TREES. COR VAR 7-00 SOUTH ON WEST LINE OF SW 1/4 SEC 28 ON A VAR 7-20 OFFSET EAST 11.22' OFFSET WEST 19.14 OFFSET EAST 17.16
  - 2661.28 INTERSECTED SOUTH BOUNDARY LINE 4.62' WEST OF CORNER FOUND STUMPS OF BOTH BEARING TREES. ESTABLISHED CORNER FROM STUMPS OF BEARING TREES. COR VAR 7-38
- 1938 SUNNY VOL 3 PG 373 FD STONE MON. 10.02 AC NEAR COR. SOUTHERLY 450.8 ALONG SEC LINE THENCE EASTERLY 992'; THENCE NORTHERLY 450.8 TO E/W 1/4 LINE; THENCE WESTERLY 994 TO W 1/4 COR SEC 28
- BATTERMAN VOL 4 PG 289 FD CUT STONE BROKEN SET CI WITH YELLOW GUARD POST. EAST OF N/W FENCE LINE. 2673.60 TO NW COR SEC 28.
- BATTERMAN VOL 4 PG 325 FD CUT STONE MON . 1967
- THOM BK 23 PG 19 "DARWOOD ADD" FD CUT STONE. 1966
- LEE #5218 FD CUT STONE MON. 1966
- JENSEN ASSESSORS PLAT SHEET 6 SUB #2183. STONE. 1969
- 1978 KIENBAUM VOL 5 PG 523 FD STONE.
- 1984 COMBS CSM VOL 11 PG 644 FD STONE.
- 1986 COMBS CSM VOL 12 PG 359 FD STONE.
- 1995 COMBS CSM VOL 18 PG 269 FD STONE.
- 1996 COMBS BK 32 PG 319 "PETTERSON WEST MEADOW" LS. @ W 1/4 COR SEC 28 5329.46 TO ALUM @ E 1/4 COR SEC 28
- COMBS BK 32 PG 355 "PETTERSON WEST MEADOW FIRST 1996 ADD. " LS. @ W 1/4 COR SEC 28 5329.46 TO ALUM @ E 1/4 COR SEC 28
- COMBS BK 32 PG 406 "WEST KNOLL" LS. @ W 1997 1/4 COR SEC 28 5329.46 TO ALUM @ E 1/4 COR SEC 28
- COMBS CSM VOL 20 PG 152 CI. SO-06-35E 2662.66 TO CUT STONE @ SE COR SEC 29
- COMBS CSM VOL 20 PG 288 CI. SO-06-35E 2662.66 TO CUT 1997 STONE @ SE COR SEC 29
- COMBS #7377 FD STONE MON. 2673.58 TO R/R SPIKE @ 1999 NW COR SEC 28
- COMBS BK 32 PG 549 "WEST KNOLL FIRST ADDITION" LS @ W 2002 1/4 COR SEC 28 5329.46 TO ALUM @ S 1/4 COR SEC 28
- COMBS CSM VOL 30 PG 262 CI N89-52-25E 1329.2X & S1-2006 O6-43E 2662.75 TO LS @ SW COR SEC 28

REMOVED 4-5' HIGH PILE OF ROCKS WITH BACKHOE. FD C.I. SURROUNDED WITH LARGE PIECES OF CUT LIMESTONE. TOP OF CI. IS BROKE OFF.

Nov21, 2011 SHEET 1 OF 3

T-9 CORNER CODE

## UN596 W1/4CORSEC28

C) Was the corner restored through acceptance of (1) an obliterated evidence location, or, (2) a found perpetuated location?

ACCEPTED FD CI, WHICH PERPETUATES THE CUT LIMESTONE.

D) Describe any material discrepancy between the location of the corner as restored or reestablished and the location of that corner as previously restored or reestablished by distance and direction. Show the discrepancy on the plan view drawing under (a), above. Show the distances between the corner as previously restored or reestablished and (1) the corner as restored or reestablished, and (2) to at least 4 of the witness monuments shown on the drawing in (a), above.

NONE

(E) Was the corner reestablished through lost corner proportionate methods? If so, show the method, including the directions and distances to other public land survey corners used as evidence or used for proportioning the corner location.

 $N\Box$ 

I, **Donald Barnes**, hereby certify that the corner location as identified by the corner code index was determined by me under my direction and control and that this U.S. Public Land Survey Monument Record is correct and complete to the best of my knowledge and belief.

SHEET 2 OF 3

CORNER CODE T-9

A.E. 7.08 REQUIREMENT

