

SURVEY MONUMENT RECORD U.S. PUBLIC LAND

For Public Land Survey Corners in the T. A. N., R. 10 E.

CORNER CODE INDEX

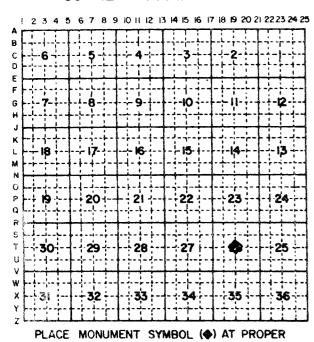

LOCATION ON ABOVE INDEX

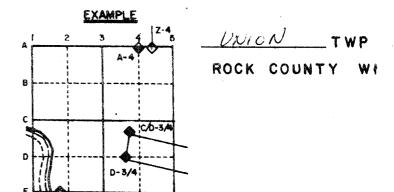


IF AVAILABLE STATE PLANE COORDINATES

North (Y) 285233,18 Eleve. (Z) 93 East (X) 2193500,03 Zone

Hor. Datum Vert. Datum

(a.)

CORNER MONUMENT Fd PIR Spike O WITNESS MONUMENT PLACED 15/8424 PIPE

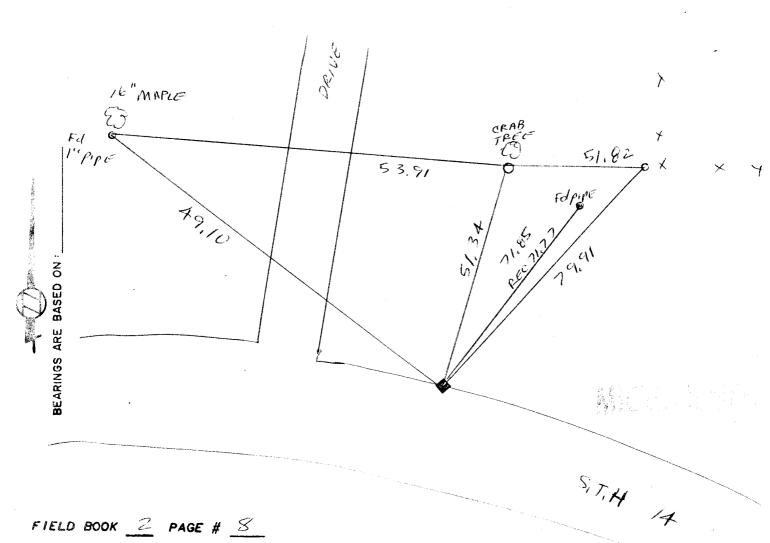


SHOW A PLAN VIEW DRAWING DEPICTING THE CORNER MONUMENT AND SURROUNDING PHYSICAL FEATURES, INCLUDING THE EXCAVATION AREA AND DEPTH. THE CORNER MONUMENT SHALL HAVE THE FOLLOWING CHARACTERISTICS: I) HAVE AT LEAST TWO PREDETERMINED BREAK-OFF POINTS. 2) IF BROKEN, LEAVE A PERMANENTLY MAGNETIZED REMNANT AT THE ORIGINAL POINT. 3) MUST BE EXTENDABLE. 4) THE CAP IS INSCRIBED : ROCK COUNTY SURVEY MONUMENT - PENALTY FOR DISTURBING MARKER. 5) OR AN EXISTING CUT LIMESTONE. AN IRON PIPE 1 1 x 4'0" (MINIMUM) MAY BE USED IN AREAS WHERE GROUND WATER IS WITHIN ONE FOOT OF THE SURFACE. IF THE CORNER IS OCCUPIED BY AN IMPROVEMENT (MANHOLE, BURIED CABLE, ETC.) ANY DURABLE, DISTINCT MONUMENT MAY BE USED. CORNERS SHALL BE REFERENCED WITH AT LEAST 4 DURABLE WITNESS MONUMENTS. WITNESS MONUMENTS SHALL BE MADE OF CONCRETE, NATURAL STONE, IRON OR OTHER EQUALLY DURABLE MATERIAL, EXCEPT WOOD. DESCRIBE THE CORNER AND THE WITNESS MONUMENTS. CORNER CODE:

- (b.) Describe any record evidence, monument evidence, occupational evidence, testimonial evidence or any other material evidence you considered, and whether the monument was found or placed.
- 1). IN 1856, CHURCH ESTABLISHED THE CORNER BY THE EQUAL DISTANCE METHOD AS PRESCRIBED BY THE LAWS OF 1853 WHICH WERE IN EFFECT UNTIL 1858.
- 2) IN 1865 LOCKE SET A LIMESTONE 18X12X3 OVER A STAKE. THIS POSITION WAS EQUAL DISTANCE FROM THE QUARTER CORNERS.
- 3) IN 1870 RUGER DECLARED THE S 1/4 CORNER LOST & ESTABLISHED IT ON LINE BETWEEN THE SE & SW CORNERS AT MID POINT.
- 4) IN 1883 RUGER STATED THAT THERE WAS A LIMESTONE 15X4X4 AT THE CENTER.
- 5) IN 1907 KERCH STATED THAT HE FOUND A STONE AT THE CENTER.
- 6) IN 1962 RH BATTERMAN JR. SET A R/R SPIKE USING THE INTERSECTION OF THE E/W & N/S QUARTER LINES.
 - (c.) Was the corner restored through acceptance of (1) an obliterated evidence location, or, (2) a found perpetuated location?
 - (d.) Describe any material discrepancy between the location of the corner as restored or reestablished and the location of that corner as previously restored or reestablished by distance and direction. Show the discrepancy on the plan view drawing under (o), above. Show the distances between the corner as previously restored or reestablished and (1) the corner as restored or reestablished, and (2) to at least 4 of the witness monuments shown on the drawing in (a), above.

(e) Was the corner reestablished through lost corner proportionate methods? If so, show the method, including the directions and distances to other public land survey corners used as evidence or used for proportioning in determining the corner location.

I, Amald Sources, hereby certify that the corner points as identified by the corner code index were, in a field survey on Apa.1 3 1985, established, re-established, monumented, re-monumented, recovered or restored as expressed below and in conformance with the regulations and rules as required in the current manual of survey instructions of the United States Department of Interior, Bureau of Land Management.

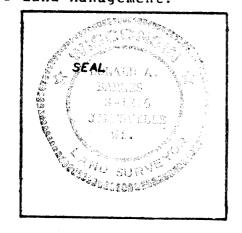

| COUNTY SURVEYOR FILING DATA |
|--------------------------------|
| Date of Computer Entry |
| Date Received |
| Date Microfilmed Apr. 130,1985 |
| Treasurer's Receipt No. |
| Number of Included Sheets |
| CORNED |

CORNER AFFIX YOUR LAND SURVEYOR SEAL. CODE 7/9