

U. S. PUBLIC LAND SURVEY MONUMENT RECORD


For Public Land Survey Corners in the
T. 4 N., R. 10 E.

CORNER CODE INDEX

	1	2	3	4	5	6	7	8	9	10	11	12	13	14	15	16	17	18	19	20	21	22	23	24	25	
A																										
B																										
C	6																									
D		5																								
E			4																							
F				3																						
G					2																					
H																										
I																										
J	7																									
K		8																								
L			9																							
M				10																						
N					11																					
O						12																				
P							13																			
Q								14																		
R									15																	
S										16																
T											17															
U												18														
V													19													
W														20												
X															21											
Y																22										
Z																	23									
																		24								
																			25							
																				26						
																					27					
																						28				
																							29			
																								30		
																									31	
																										32
																										33
																										34
																										35
																										36

PLACE MONUMENT SYMBOL (◆) AT PROPER LOCATION ON ABOVE INDEX

EXAMPLE

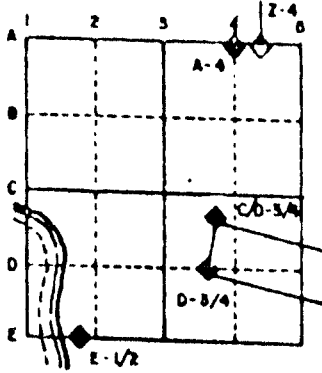

UNION TWP
ROCK COUNTY WI

IF AVAILABLE
STATE PLANE COORDINATES

North (Y) _____ Eleve. (Z) _____
 East (X) _____ Zone _____
 Hor. Datum _____ Vert. Datum _____


◆ CORNER MONUMENT

○ WITNESS MONUMENT

- ◆ 26" CAST IRON MONUMENT WITH CARSONITE POST
- 3/4X24 REROD WITH PLASTIC CAP

FIELD BOOK #2 PG 35 & 42

BEARINGS ARE BASED ON: ASSUMED

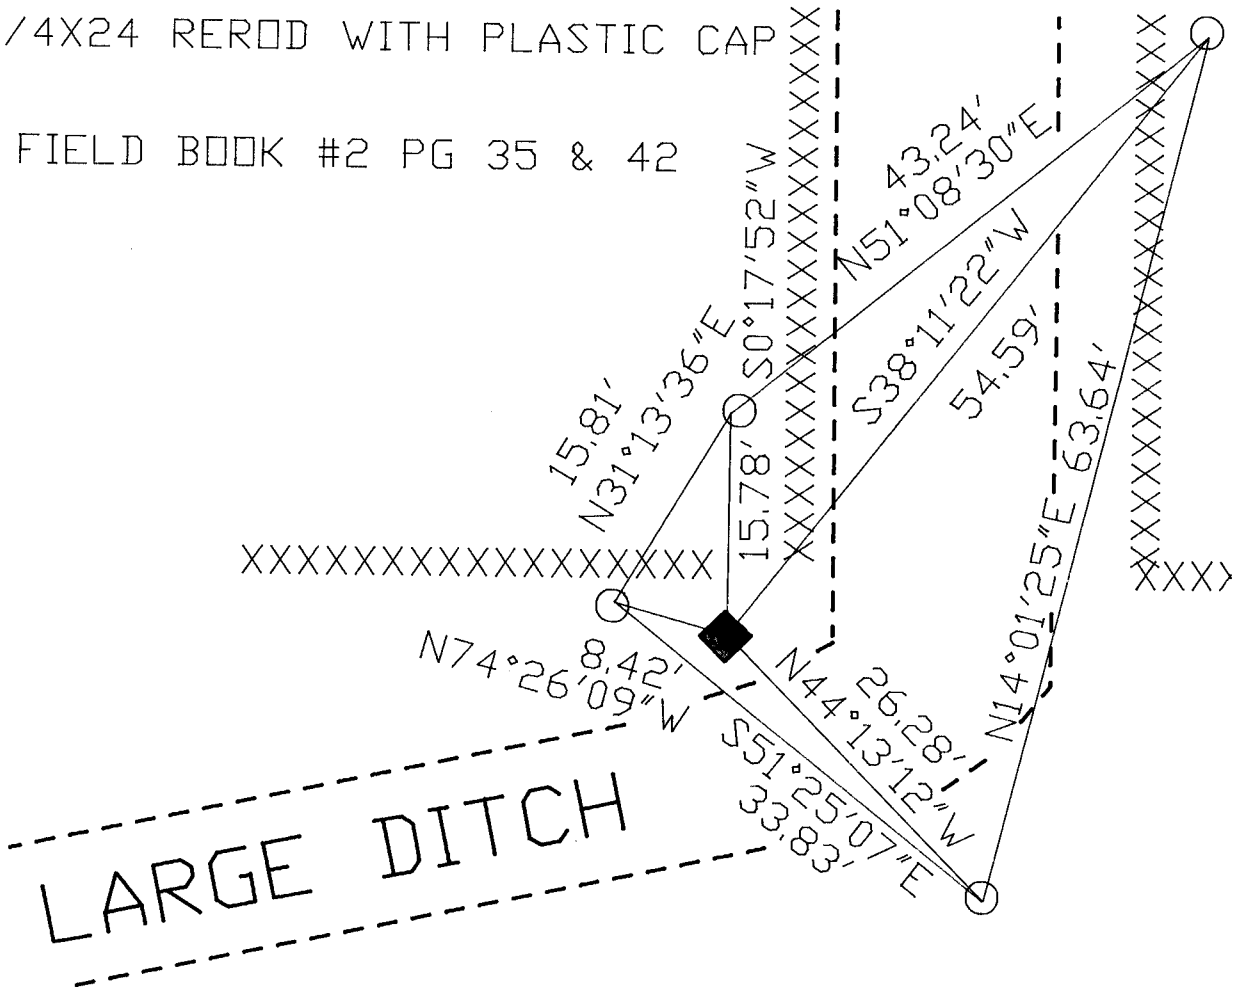

SHEET _____ OF _____

CORNER CODE: 29

(B) Describe any record evidence, monument evidence, occupational evidence, testimonial evidence or any other material evidence you considered, and whether the monument was found or placed.

1863 LOCKE VOL 1 PG 183 FOUND OLD STAKE. SHOWS THAT CORNER IS 173.58' EAST OF THE NE CORNER OF SECTION 5 AND 5254.26 TO THE SW CORNER OF SECTION 33.

1863 LOCKE VOL 1 PG 196 CALLS FOR OLD STAKE STANDING IN INTERSECTION OF SOD FENCES, 173.58 EAST OF NE CORNER OF SECTION 4, AND 2619.54 TO THE SOUTH QUARTER CORNER OF SECTION 33.

1870 RUGER - REMONUMENTATION. EAST ON SOUTH LINE OF SE 1/4 OF SECTION 32 ON A VAR 6-30 OFFSET 3.63 AT 2629.11 INTERSECTED EAST BOUNDARY LINE 8.58 SOUTH OF CORNER. FOUND OLD STAKE. CORRECTED VAR 6-36. CALLS FOR A DISTANCE OF 2623.01 TO THE SOUTH QUARTER CORNER AND 2655.18 TO THE WEST QUARTER CORNER OF SECTION 33.

1891 BLEEDORN VOL 2 PG 457 CALLS FOR A MONUMENT.

FOUND CUT LIMESTONE 2.6' LONG LEANING TO THE NORTH WEST AND TOP IN BOTTOM OF HOLE. FOUND BASE OF LIMESTONE. PLACED 26" LONG CAST IRON MONUMENT ON TOP OF STONE AND CARSONITE POST NEXT TO CAST IRON MONUMENT.


C) Was the corner restored through acceptance of (1) an obliterated evidence location, or, (2) a found perpetuated location?

ACCEPTED FOUND PERPETUATED LOCATION.

D) Describe any material discrepancy between the location of the corner as restored or reestablished and the location of that corner as previously restored or reestablished by distance and direction. Show the discrepancy on the plan view drawing under (a), above. Show the distances between the corner as previously restored or reestablished and (1) the corner as restored or reestablished, and (2) to at least 4 of the witness monuments shown on the drawing in (a), above.

(E) Was the corner reestablished through lost corner proportionate methods? If so, show the method, including the directions and distances to other public land survey corners used as evidence or used for proportioning the corner location.

I, Donald Barnes, hereby certify that the corner points as identified by the corner code index were, in a field survey on, MAY 20, 1991, established, re-established, monumented, re-monumented, recovered or restored as expressed below and in conformance with the regulations and rules as required in the current manual of survey instructions of the United States Department of the Interior, Bureau of Land Management.

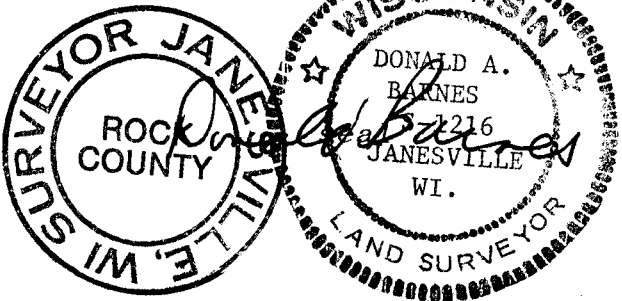

AFFIX YOUR LAND SURVEYOR SEAL

COUNTY SURVEYOR FILING DATA

Date of computer entry _____

Date microfilmed _____

Number of included sheets _____
CORNER CODE