


U.S. PUBLIC LAND SURVEY MONUMENT RECORD

For Public Land Survey Corners in the
T. 4 N., R. 10 E.

CORNER CODE INDEX

	1	2	3	4	5	6	7	8	9	10	11	12	13	14	15	16	17	18	19	20	21	22	23	24	25
A																									
B																									
C	6																								
D		5																							
E			4																						
F				3																					
G					2																				
H	7																								
I		6																							
J			5																						
K				4																					
L	16																								
M		15																							
N			14																						
O				13																					
P	19																								
Q		20																							
R			21																						
S				22																					
T					23																				
U						24																			
V							25																		
W	30																								
X		29																							
Y			28																						
Z				27																					
					26																				
						25																			
							24																		
EXAMPLE

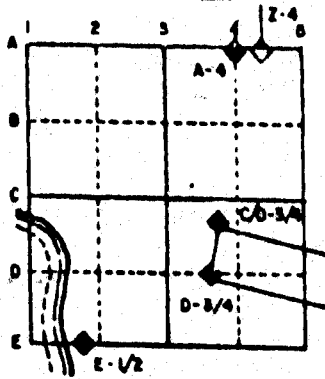

UNION TWP
ROCK COUNTY WI

IF AVAILABLE
STATE PLANE COORDINATES


North (Y) _____ Elev. (Z) _____
 East (X) _____ Zone _____
 Hor. Datum _____ Vert. Datum _____

PLACE MONUMENT SYMBOL (◆) AT PROPER
LOCATION ON ABOVE INDEX

◆ CORNER MONUMENT

○ WITNESS MONUMENT

BEARINGS ARE BASED ON: ASSUMER

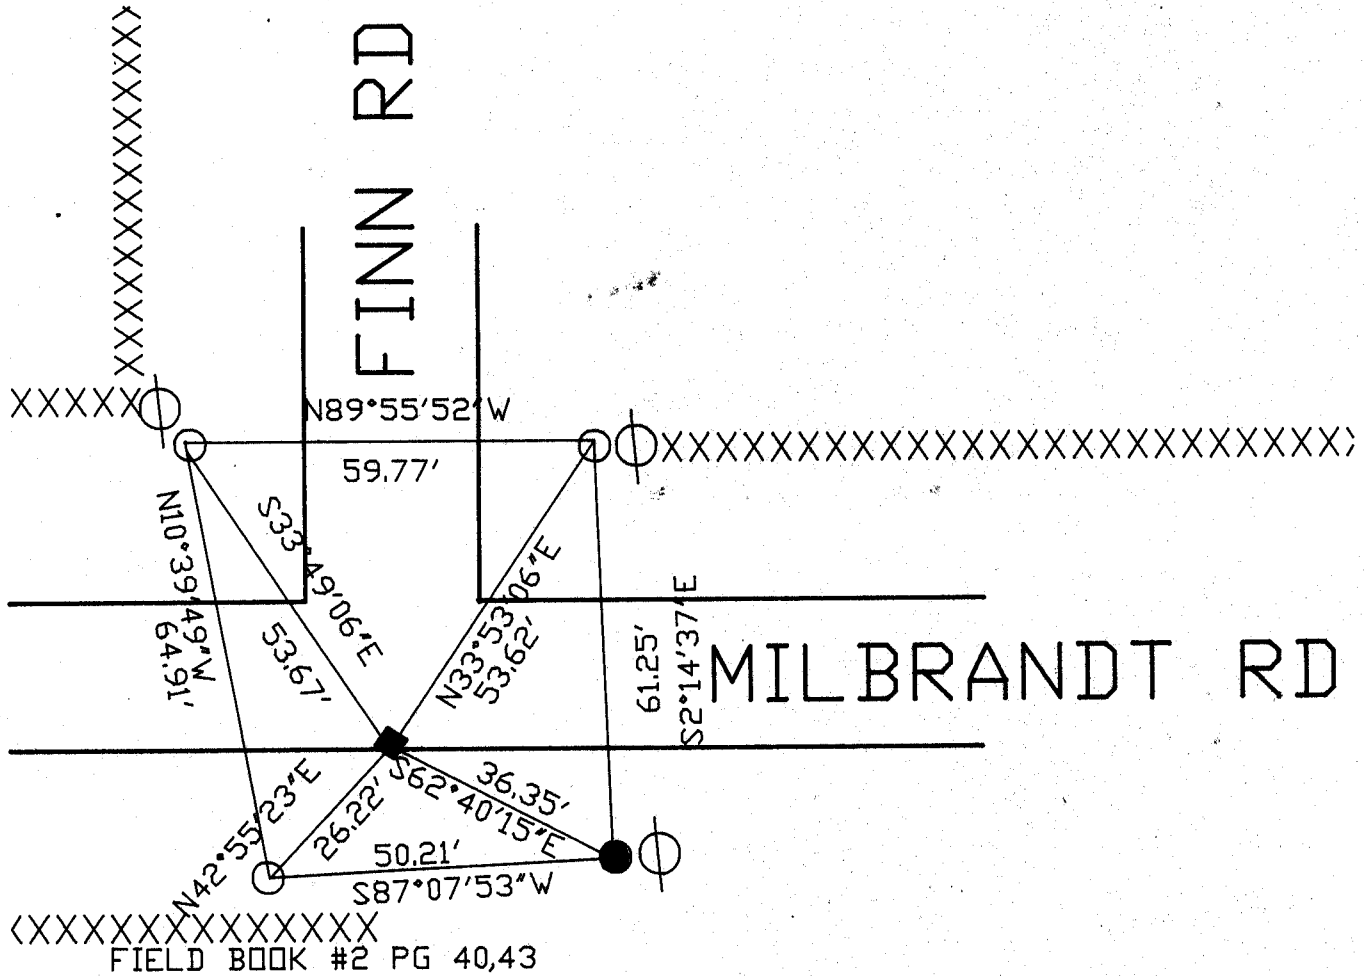

- 3/4X24 REROD WITH PLASTIC CAPS
- FD 3/8" REROD
- ◆ PLACED POLY MON. ON TOP OF STONE

MICROFILMED

SHEET 1 OF 1

CORNER CODE: 27

.(B) Describe any record evidence, monument evidence, occupational evidence, testimonial evidence or any other material evidence you considered, and whether the monument was found or placed.

1863 LOCKE VOL 1 PG 183 STATES THAT HE FOUND SET STONE EAST OF N 1/4 CORNER SECTION 5 BUT SHOWS NO DISTANCES.

1870 RUGER - REMONUMENTATION. COMMENCING AT THE SW CORNER SECTION 32 VAR 7-10 AT 2628.112 INTERSECTED QUARTER LINE 3.3' NORTH OF QUARTER CORNER. FOUND OLD STAKE ON CORNER. ALSO FOUND STUMPS OF BOTH BEARING TREES. CORRECTED VAR 7-06

EAST ON A VAR 6-30 OFFSET SOUTH 3.63' AT 2629.1 INTERSECTED EAST BOUNDARY LINE 8.58' SOUTH OF CORNER. FOUND OLD STAKE AT CORNER. CORRECTED VAR 6-36.

1900 BROWN VOL 2 PG 518 CALLS FOR A MONUMENT USED TO SUBDIVIDE SECTION 32. SHOWS 2635.05 TO THE SW CORNER OF SECTION 32 AND 1317.52 TO AN IRON ON THE SOUTH LINE OF THE SW 1/4 OF SECTION 32.

1968 BATTERMAN JR. VOL 4 PG 365 FOUND CUT LIMESTONE 1 1/2 DEEP. PLACED 16PD NAILS IN 3 UTILITY POLES.

BATTERMAN JR. TIES ARE GONE. DUG AND FOUND CUT LIMESTONE 2.7' DEEP WITH TOP BROKEN OFF. CORNER IS ON LINE WITH CENTER OF PAVEMENT TO THE NORTH AND ON THE SOUTH EDGE OF THE E/W PAVEMENT. PLACED MAGNET NEXT TO STONE AND POLY MONUMENT ON TOP.

C) Was the corner restored through acceptance of (1) an obliterated evidence location, or, (2) a found perpetuated location?


ACCEPTED FOUND PERPETUATED LOCATION.

D) Describe any material discrepancy between the location of the corner as restored or reestablished and the location of that corner as previously restored or reestablished by distance and direction. Show the discrepancy on the plan view drawing under (a), above. Show the distances between the corner as previously restored or reestablished and (1) the corner as restored or reestablished, and (2) to at least 4 of the witness monuments shown on the drawing in (a), above.

(E) Was the corner reestablished through lost corner proportionate methods? If so, show the method, including the directions and distances to other public land survey corners used as evidence or used for proportioning the corner location.

I, Donald Barnes, hereby certify that the corner points as identified by the corner code index were, in a field survey on, MAY 20, 1

1991, established, re-established, monumented, re-monumented, recovered or restored as expressed below and in conformance with the regulations and rules as required in the current manual of survey instructions of the United States Department of Interior, Bureau of Land Management.

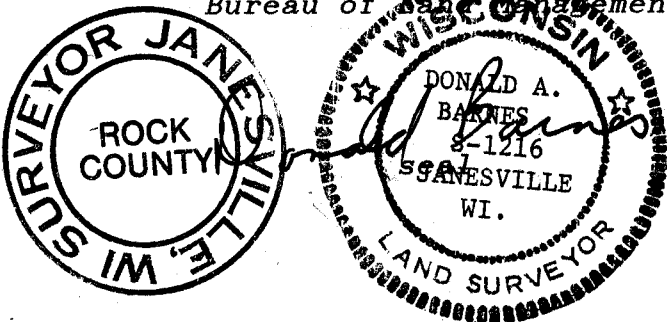

COUNTY SURVEYOR FILING DATA

Date of computer entry _____

Date microfilmed _____

Number of included sheets _____
CORNER CODE

AFFIX YOUR LAND SURVEYOR SEAL