

Paper weight-110# (minimum)

ack nonfading ink required

U.S. PUBLIC LAND SURVEY MONUMENT RECORD

For Public Land Survey Corners In:

WI ADMINISTRATIVE CODE A-E 7.08 REQUIREMENT

T. 4 N. R. 10 E. 4th P.M.

REV 10/23/2004

USMONREC.DWG

CORNER CODE INDEX

1	2	3	4	5	6	7	8	9	10	11	12	13	14	15	16	17	18	19	20	21	22	23	24	25	
A																									A
B	6					5					4					3					2			1	B
C																									C
D																									D
E																									E
F																									F
G	7					8					9					10					11			12	G
H																									H
J																									J
K	18					17					16					15					14			13	K
L																									L
M																									M
N																									N
O																									O
P	19					20					21					22					23			24	P
Q																									Q
R																									R
S																									S
T	30					29					28					27					26			25	T
U																									U
V																									V
W																									W
X	31					32					33					34					35			36	X
Y																									Y
Z																									Z

UNION TWP
ROCK COUNTY WI

IF AVAILABLE
ROCK COUNTY COORDINATES PREFERRED

North _____ Elev. _____

East _____

Hor. Datum _____ Vert. Datum _____

LATITUDE _____ ELLIPS. HT. _____

LONGITUDE _____

NAD83(91) _____ NETWORK ADJ. YR 2010

GPS (X) _____ TRAVERSE (X) X

BASED ON THE FOLLOWING CONTROL:

PLACE MONUMENT SYMBOL AT PROPER LOCATION ON ABOVE INDEX

CORNER MONUMENT

WITNESS MONUMENT

(a)

BEARINGS ARE BASED ON: ROCK COUNTY PROJECTION

E 1/4 COR
SEC 1
T3N R9E

FIELD BOOK _____ PAGE # _____

OR OBSERVATION SHEET _____

SHEET 1 OF 2

SHOW A PLAN VIEW DRAWING DEPICTING THE CORNER MONUMENT AND SURROUNDING PHYSICAL FEATURES, INCLUDING THE EXCAVATION AREA AND DEPTH.

PLANNING & ZONING COMMITTEE ADOPTED THIS FORM ON 12/2/1982

CORNER CODE XX-1

UN 5520 E 1/4 COR SEC 1 T3 R9E

(B) Describe any record evidence, monument evidence, occupational evidence, testimonial evidence or any other material evidence you considered, and whether the monument was found or placed.

1833 MULLETT NORTH ON THE EAST SIDE OF SECTIONS NO. 1 OF
T3N R9E (NW TERR)
1320 ENTER PRAIRIE
1676.4 A SMALL SPRING RUNNING EAST
2640 SET 1/4 OAK IN PRAIRIE & MADE MOUND & C
5280 INTERSECTED SOUTH BOUNDARY OF T4 AS RUN
OUT FROM SUGAR CREEK. SET POST FOR
CORNER TO TOWNSHIPS 3 & 4 NORTH, RANGE 9
EAST IN PRAIRIE AND MADE A MOUND, & C. LAND
ROLLING SECOND RATE PRAIRIE HAZEL GRASS, &
C

SEP. 11 1833

1833 BRINK (SOUTH BOUNDARY T4N 9E) NORTH BOUNDARY SEC 1
T3N R9E
OBS AT THIS CORNER VAR 8-10E
WEST ON SOUTH SIDE SEC 36
2640.00 SET 1/4 SECTION POST IN PRAIRIE. MADE MOUND
@ C.
4620.00 LEAVE PRAIRIE
5280.00 SET POST CORNER SECTIONS 35 & 36 BUR OAK
10" N74W 27.06' BUR OAK 10" N17E 31.68'
LAND ROLLING SECOND RATE DRY PRAIRIE,
GRASS & C

1978 TALARCZYK #6987 ALUMINUM MONUMENT. CORNER SET BY
PROPORTIONATE MEASUREMENT & EXISTING PHYSICAL
EVIDENCE.

FD ALUM 1 1" DEEP & NW REFERENCE PIN. MON IS 1' EAST OF
CENTER OF PVMT. N00-51-08W 2636.59 TO NE COR SEC 1, S00-
43-49E 2636.48 TO SE COR SEC 1. MON. IS 2.77' EAST OF LINE
BETWEEN SW & W 1/4 CORNERS SEC 31. 2.81' EAST OF LINE
BETWEEN SE-NE CORNERS SEC 1.

C) Was the corner restored through acceptance of (1) an obliterated evidence location, or, (2) a found perpetuated location?

DID NOT ACCEPT NOR REJECT MONUMENT.

D) Describe any material discrepancy between the location of the corner as restored or reestablished and the location of that corner as previously restored or reestablished by distance and direction. Show the discrepancy on the plan view drawing under (a), above. Show the distances between the corner as previously restored or reestablished and (1) the corner as restored or reestablished, and (2) to at least 4 of the witness monuments shown on the drawing in (a), above.

(E) Was the corner reestablished through lost corner proportionate methods? If so, show the method, including the directions and distances to other public land survey corners used as evidence or used for proportioning the corner location.

I, Donald Barnes, hereby certify that the corner location as identified by the corner code index was determined by me under my direction and control and that this U.S. Public Land Survey Monument Record is correct and complete to the best of my knowledge and belief.


Donald Barnes

4/10/2012


SHEET 1 OF 2

CORNER CODE X/Y-1

A.E. 7.08 REQUIREMENT



ROCK COUNTY PROJECTION

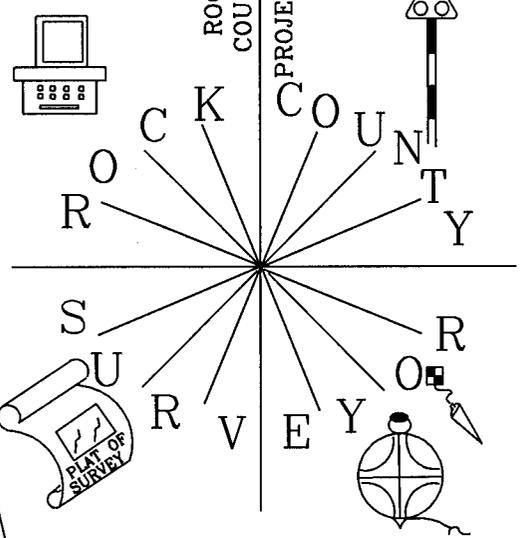

NOT TO SCALE

FD DISK IN CONC MON. ALLEN AZM

XXXXXX SET 5/8X24 REROD

XXXXXX NO-54-26W 564.25

N7-25-36E 87.62

S17-32-02E 123.44

N3-52-06W 683.45

NO-56-36W 921.23 TO W 1/4 COR SEC 31 T4N R10E

NE COR SEC 1

1833 DRIG 2640 NO-51-08W 2636.59

FD 1 1/4" PIN

S26-01-27E 34.97

S57-34-12E 57.48 1976 57.48

33.18 N88-57-24E


FD ALUM 11" DEEP

NO-47-29W 5273.06 E 1/4 COR SEC 1

2.81

FD 3/4" PIN

1976 51.72

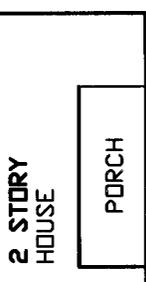

1976 76.18

S31-09-07E 117.77

1'

S15-18-33E 105.12

SE COR SEC 1

S0-43-49E 2636.48 1833 DRIG 2640.00

1976 48

E 1/4 COR SEC 1 T3N R9E

STH 104 OLD CTH T

SET 5/8X24 REROD

SHEET 2 OF 2

X/Y-1

Donald Barnes 4/10/2012