


U.S. PUBLIC LAND SURVEY MONUMENT RECORD

For Public Land Survey Corners in the
T. 2 N., R. 12 E.

CORNER CODE INDEX

	1	2	3	4	5	6	7	8	9	10	11	12	13	14	15	16	17	18	19	20	21	22	23	24	25
A																									
B																									
C	6																								
D		5																							
E			4																						
F				3																					
G					2																				
H	7																								
I		8																							
J			9																						
K				10																					
L					11																				
M						12																			
N	16																								
O		17																							
P			18																						
Q				19																					
R					20																				
S						21																			
T							22																		
U								23																	
V									24																
W										25															
X											26														
Y												27													
Z													28												
														29											
															30										
																31									
																	32								
																		33							
																			34						
																				35					
																					36				

EXAMPLE

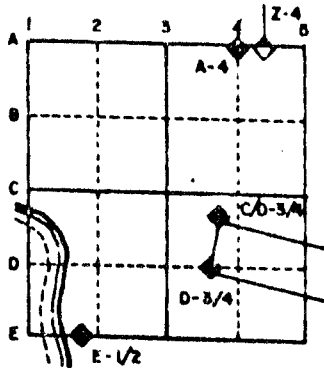

ROCK TWP
ROCK COUNTY WI

IF AVAILABLE
STATE PLANE COORDINATES

NAD North (Y) 246,352.15 Elev. (Z) 856.0
27 East (X) 2,255,164.06 Zone _____

Hor. Datum _____ Vert. Datum _____
JANESVILLE PROJECT WPL 246,350.79
246,352.31 2,255,163.73
2,255,163.88

PLACE MONUMENT SYMBOL (◆) AT PROPER
LOCATION ON ABOVE INDEX

◆ CORNER MONUMENT

○ WITNESS MONUMENT

Poly Mon.

BEARINGS ARE BASED ON: ASSUMED

CROSBY RD.

ROCKPORT RD

EAST REC 101.68 EAST REC 90.79 EAST REC 83.59

○ 3/8X32 BOLT

MICROFILMED

SHEET ___ OF ___

CORNER CODE: A17

