

# U.S. PUBLIC LAND SURVEY MONUMENT RECORD


For Public Land Survey Corners in the  
T. 2 N., R. 12 E.

## CORNER CODE INDEX

	1	2	3	4	5	6	7	8	9	10	11	12	13	14	15	16	17	18	19	20	21	22	23	24	25
A																									
B																									
C	6																								
D		5																							
E			4																						
F				3																					
G					2																				
H																									
I																									
J																									
K																									
L																									
M																									
N																									
O																									
P																									
Q																									
R																									
S																									
T																									
U																									
V																									
W																									
X																									
Y																									
Z																									

PLACE MONUMENT SYMBOL (◈) AT PROPER LOCATION ON ABOVE INDEX

### EXAMPLE

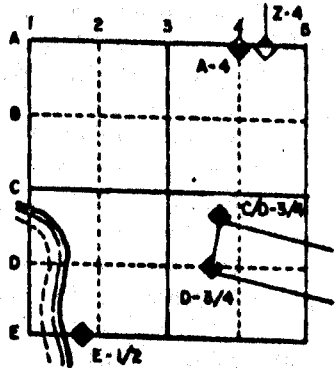


ROCK TWP  
ROCK COUNTY WI

IF AVAILABLE  
STATE PLANE COORDINATES

North (Y) \_\_\_\_\_ Eleve. (Z) \_\_\_\_\_  
 East (X) \_\_\_\_\_ Zone \_\_\_\_\_  
 Hor. Datum \_\_\_\_\_ Vert. Datum \_\_\_\_\_

e.) ◈ CORNER MONUMENT      ○ WITNESS MONUMENT

BEARINGS ARE BASED ON: TOWNSHIP PROJECT

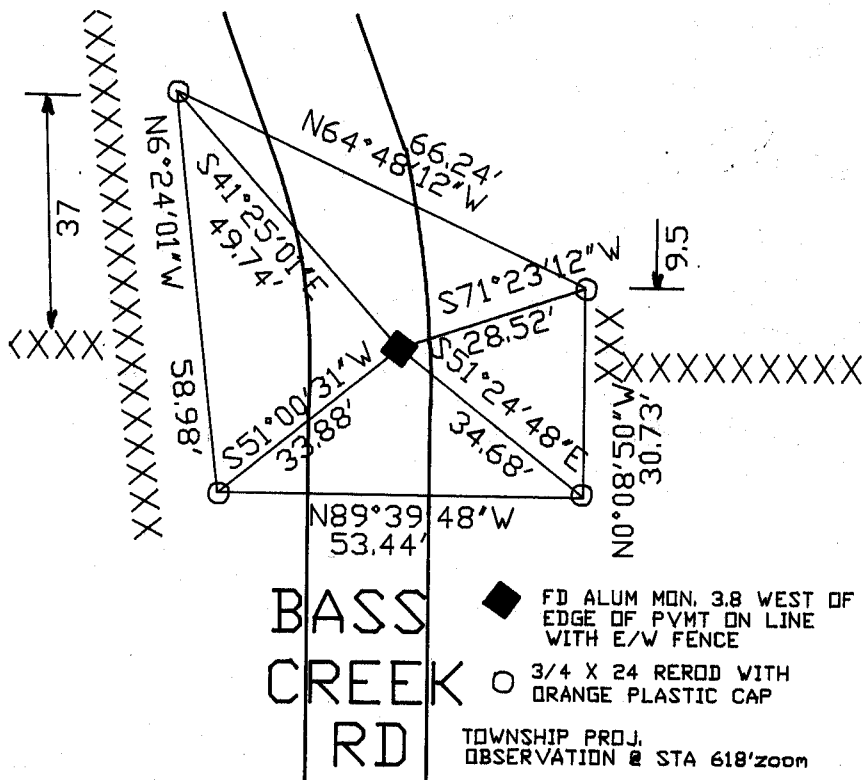

**MICROFILMED**

SHEET \_\_\_ OF \_\_\_

CORNER CODE: X 17

(B) Describe any record evidence, monument evidence, occupational evidence, testimonial evidence or any other material evidence you considered, and whether the monument was found or placed.

1834 HARRISON ORIGINAL GOVERNMENT SURVEYOR. FIELD NOTES- QUARTER SECTION CORNER IN PRAIRIE. SET POST AND RAISED MOUND.

1858 CHURCH VOL 1 PG 80 SHOWS 2656.50 TO CENTER OF SEC 34 AND 2645.28 TO SE CORNER OF SECTION 34.

1874 RUGER VOL 2 PG 143. FOUND LIMESTONE AT CORNER. THE CORNER IS 33' FROM FENCE ON WEST SIDE OF ROAD AND IN LINE WITH FENCE RUNNING WEST. SHOWS 2655.51 TO THE SE CORNER OF SECTION 34.

1891 BLEEDORN VOL 2 PG 443 FOUND CORNER SET BY RUGER SHOWS 2657.16 TO SW CORNER SECTION 35 AND 2647.26 TO CENTER OF SECTION 35.

1935 SUNNY VOL 3 PG 275 FOUND STONE MONUMENT 4"X4". SHOWS N4-20W 2657.2 TO NW CORNER OF SECTION 35.

FOUND ALUMINUM MONUMENT.



C) Was the corner restored through acceptance of (1) an obliterated evidence location, or, (2) a found perpetuated location?

ACCEPTED FOUND MONUMENT.

D) Describe any material discrepancy between the location of the corner as restored or reestablished and the location of that corner as previously restored or reestablished by distance and direction. Show the discrepancy on the plan view drawing under (a), above. Show the distances between the corner as previously restored or reestablished and (1) the corner as restored or reestablished, and (2) to at least 4 of the witness monuments shown on the drawing in (a), above.

(E) Was the corner reestablished through lost corner proportionate methods? If so, show the method, including the directions and distances to other public land survey corners used as evidence or used for proportioning the corner location.

I, Donald Barnes, hereby certify that the corner points as identified by the corner code index were, in a field survey on, July 20, 1990, established, re-established, monumented, re-monumented, recovered or restored as expressed below and in conformance with the regulations and rules as required in the current manual of survey instructions of the United States Department of Interior, Bureau of Land Management.

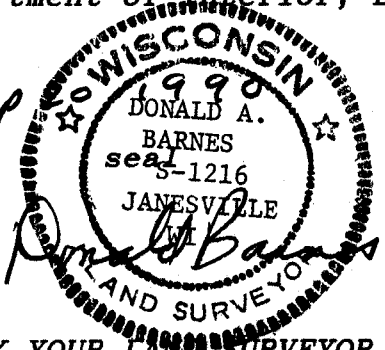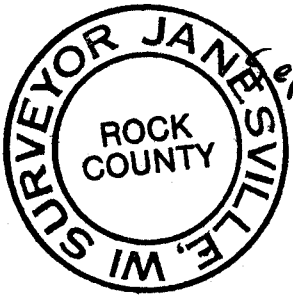

COUNTY SURVEYOR FILING DATA

Date of computer entry \_\_\_\_\_

Date microfilmed \_\_\_\_\_

Number of included sheets \_\_\_\_\_  
CORNER CODE

AFFIX YOUR LAND SURVEYOR SEAL

X 17