

U.S. PUBLIC LAND SURVEY MONUMENT RECORD

For Public Land Survey Corners in the


T. 2 N., R. 12 E.

CORNER CODE INDEX

	1	2	3	4	5	6	7	8	9	10	11	12	13	14	15	16	17	18	19	20	21	22	23	24	25
A																									
B																									
C	6				5				4					3					2						
D																									
E																									
F																									
G	7				8				9					10					11						
H																									
J																									
K																									
L	18				17				16					15					14						
M																									
N																									
O																									
P	19				20				21					22					23						
Q																									
R																									
S																									
T	30				29				28					27					26						
U																									
V																									
W																									
X																									
Y	31				32				33					34					35						
Z																									

PLACE MONUMENT SYMBOL (◆) AT PROPER LOCATION ON ABOVE INDEX

EXAMPLE

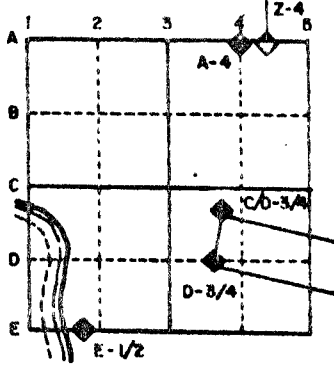

ROCK _____ TWP
ROCK COUNTY WI

IF AVAILABLE
STATE PLANE COORDINATES

North (Y) _____ Eleve. (Z) _____
 East (X) _____ Zone _____
 Hor. Datum _____ Vert. Datum _____

o.) ◆ CORNER MONUMENT ○ WITNESS MONUMENT

BEARINGS ARE BASED ON:

SEE REVERSE SIDE


SHEET ___ OF ___

CORNER CODE: Z 17

FIELD SURVEY NOTES
PRESERVATION OF LANDMARKS
 (Pursuant to Section 59.635(7) Wisconsin Statutes)


State Highway Commission of Wisconsin
 Form E-D-707-85

COUNTY <i>Rock</i>		
TOWN <i>of Rock</i>		
HIGHWAY <i>Townline</i>		
SECTION <i>34</i>	TOWNSHIP <i>T2N</i>	RANGE <i>R12E</i>
TYPE OF LANDMARKS <i>witness</i> ① <i>Brass Cap Conc Monuments (Type A)</i>		

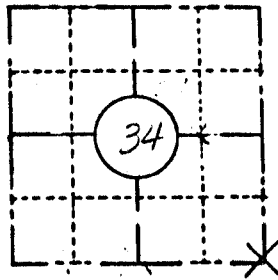

LOCATION SKETCH
 (Location of landmark indicated by "x")

This space for copy of field notes or ties to the above described landmarks

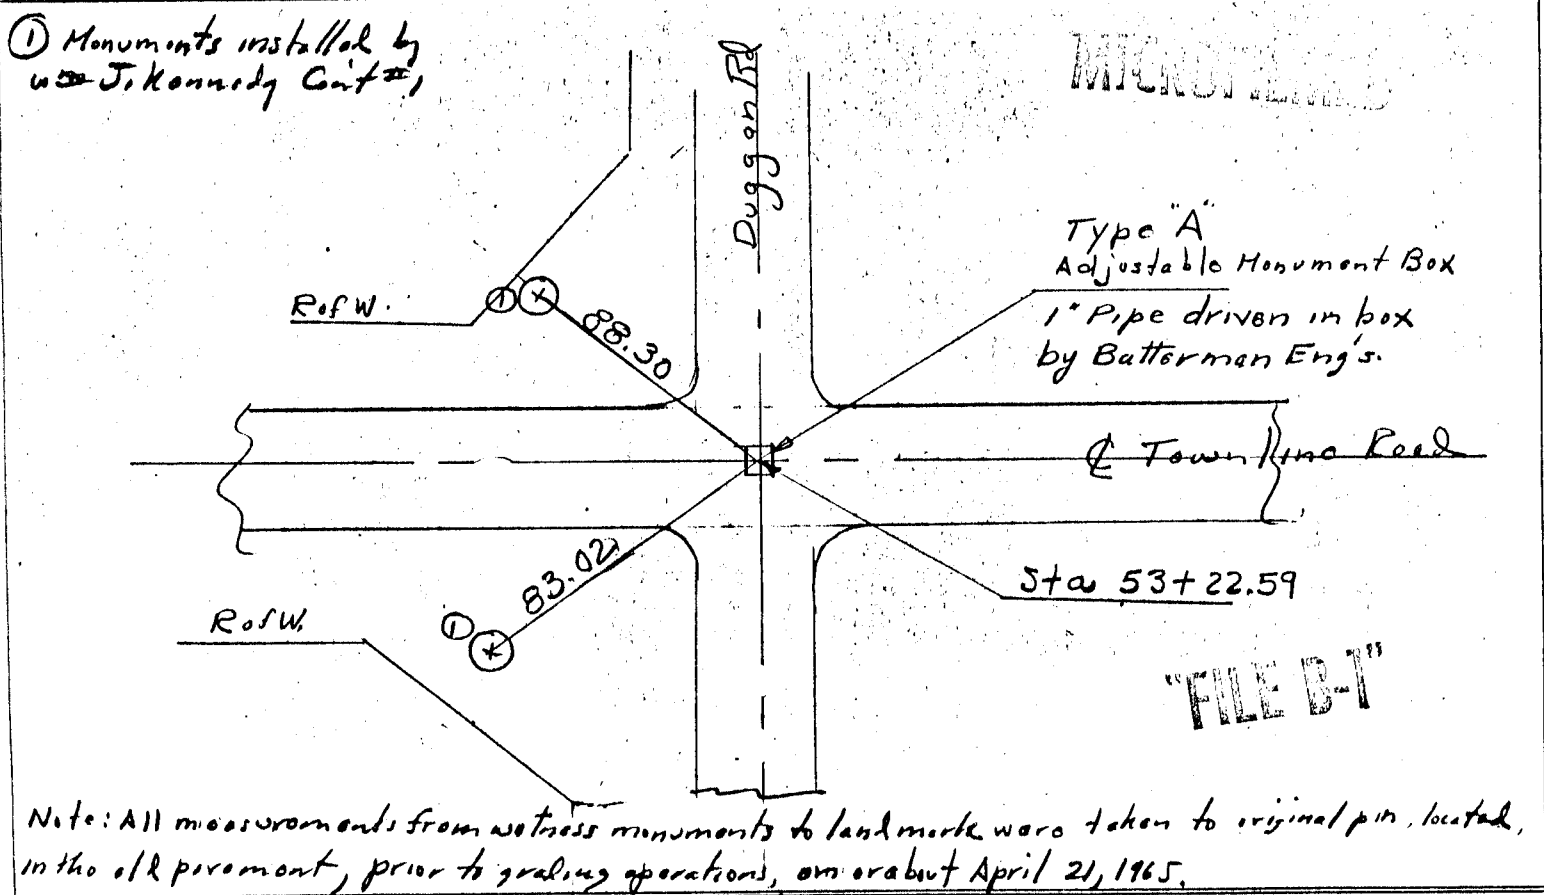

FILED UNDER PROJECT NUMBER <i>5062C(5)</i>			COUNTY CLERK'S OFFICE COUNTY OF <i>DANE</i> WISCONSIN } 55	
SHC DISTRICT OFFICE NUMBER <i>ONE</i>	CITY <i>MADISON</i>	COUNTY <i>DANE</i>	DATE RECEIVED FOR RECORD	DATE COPY SENT TO COUNTY SURVEYOR <i>12/20/65</i>
LOCATED OR ESTABLISHED BY NAME <i>O. I. Koski</i>			SIGNATURE OF COUNTY CLERK	
TITLE <i>Proj Eng</i> DATE _____				