

UBLIC LAND SURVET MONUMENT RECORD

For Public Land Survey Corners in the T. 4 N., R. 10 E.

CORNER CODE INDEX

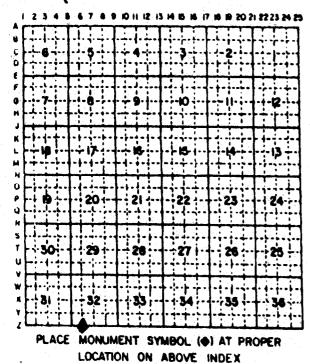

e.)

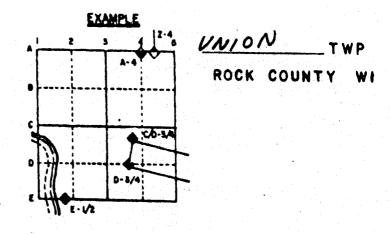

IF AVAILABLE
STATE PLANE COORDINATES


North (Y) Eleve. (2)

East (X) Zone

Hor. Datum Vert. Datum

CORNER MONUMENT

O WITNESS MONUMENT

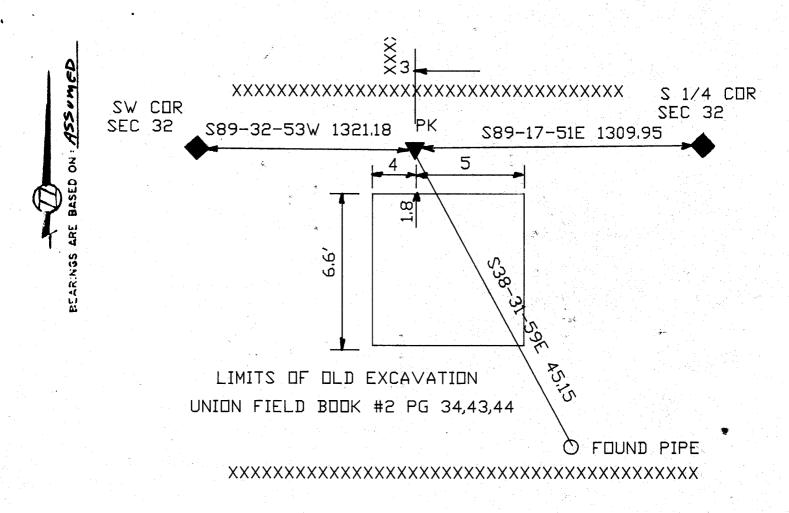


MICROFILMED OF___

CORNER CODE: 26

- Describe any record evidence, monument evidence, occupational evidence, testimonial evidence or any other material evidence you considered, and whether the monument was found or placed.
- 1900 BROWN VOL 2 PG 518 PLACED IRON 1317.52 WEST OF THE SOUTH QUARTER CORNER OF SECTION 32 AND ON THE SOUTH LINE OF THE SW 1/4 OF SECTION 32.
- 1968 BATTERMAN JR. VOL 4 PG 365 FOUND LIMESTONE 1.5' DEEP AND REFERENCED SAME WITH 3 REFERENCE PIPES. CALLS FOR IT AS THE W 1/16 COR SEC 32/5.

DID NOT FIND THE NW AND NE REFERENCE PIPES. REFERENCE PIPE (REC 40.16'). ALSO FOUND THE FOUND THE SE ALSO FOUND THE OLD EXCAVATION THE PK THAT I PLACED IS 4.7 NORTH OF THE CENTER OF THE PAVEMENT. I DUG 2.8' DEEP AT RECORD DISTANCE FROM THE FOUND REFERENCE PIPE. I STARTED AT THE SW CORNER OF THE PATCH AND DUG A 2' WIDE HOLE UNTIL I WAS 2 NORTH OF THE CENTER OF THE I FOUND NOTHING. PAVEMENT.

- Was the corner restored through acceptance of (1) an obliterated evidence location, or, (2) a found perpetuated location? DID NOT RESTORE CORNER.
- Describe any material discrepancy between the location of the corner as restored or reestablished and the location of that corner as previously restored or reestablished by distance and direction. Show the discrepancy on the plan view drawing under (a), above. Show the distances between the corner as previously restored or reestablished and (1) the corner as restored or reestablished, and (2) to at least 4 of the witness monuments shown on the drawing in (a), above.
- Was the corner reestablished through lost corner proportionate methods? If so, show the method, including the directions and distances to other public land survey corners used as evidence or used for proportioning the corner location.
- I, Donald Barnes, hereby certify that the corner points as identified by the corner code index were, in a field survey on, JULY 30 1991, established, re-established, monumented, remonumented, recovered or restored as expressed below and in conformance with the regulations and rules as required in the current manual of survey instructions of the United States
 Department of Donard Bureau of Land Management.

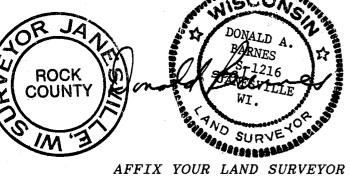

COUNTY SURVEYOR FILING DATA Date of computer entry__ Date microfilmed __ Number of included sheets CORNER CODE

AFFIX YOUR LAND SURVEYOR SEAL