Paper weight-110# (minimum)

Black nonfading ink required


## LAND U.S. SURVEY **PUBLIC** MONUMENT RECORD

Public Land Survey Corners In:

WI ADMINISTRATIVE CODE A-E 7.08 REQUIREMENT

T. 4 N. R. 10 E. 4th P.M.

CORNER CODE INDEX

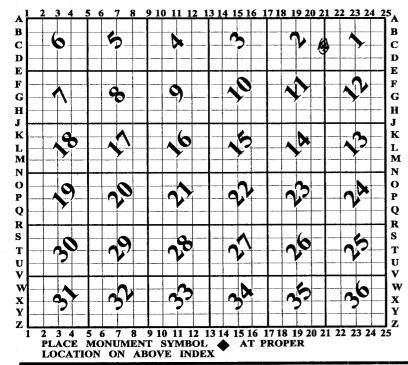

**UNION TWP ROCK COUNTY WI** 

IF AVAILABLE ROCK COUNTY COORDINATES PERFERRED

North	Elev.
East	
Hor. Datum	Vert. Datum
LATITUDE	ELLIPS. HT.
LONGITUDE	
NAD83(91)	NETWORK ADJ. YR 2010
GPS (X)	TRAVERSE (X) X
BASED ON THE	FOLLOWING CONTROL:

**◆ CORNER MONUMENT** 

WITNESS MONUMENT

(a) ROCK COUNTY PROJECTION BEARINGS ARE BASED ON:\_

·					
FIELD BOOK PAGE #		/		>	
OR OBSERVATION SHEET	SHEET		OF		
SHOW A PLAN VIEW DRAWING DEPICTING THE CORNER MONUMENT AND S	URROUN	DING			
PHYSICAL FEATURES, INCLUDING THE EXCAVATION AREA AND DEPTH.					
PLANNING & ZONING COMMITTEE ADOPTED THIS FORM ON 12/2/1982		_			
		$\sim$	_	,	

## UN519 W1/4CORSEC1

(B) Describe any record evidence, monument evidence, occupational evidence, testimonial evidence or any other material evidence you considered, and whether the monument was found or placed.

1833 HARRISON T4N R1DE NORTH BET. SECS 1 & 2

LEAVE PRAIRIE & ENTER TIMBER 2145.0

SET COR TO QUARTER SEC {BURR O 8" 2640.0

N87E 51.48

INT. N BDY 12.54' WEST OF POST {BLK O 5205.42 24" S50E 172.92', W.O. 18" S51W

109.56

LAND LEVEL 2ND RATE ALONG N 1/2 ROLLING 1ST RATE PRAIRIE SOUTH 1/2 NOV 5 1833

REMON-106 NORTH ON WEST LINE OF SW RUGER AUG 1870 1/4 SEC 1 ON A VAR 6-45; AT

2659.80 INTERSECTED QUARTER LINE 7.26'. EAST OF QUARTER CORNER. FOUND OLD STAKE AT CORNER. COR. VAR 6-55' SEPTEMBER 2 1870 NORTH ON WEST LINE OF NW 1/4 SEC 1 ON A VAR 6-45 AT

2443.32 INTERSECTED NORTH BOUNDARY LINE 6.6' EAST OF CORNER FOUND OLD STAKE AT CORNER. ALSO FOUND WEST BEARING TREE. COR VAR 6-54

- RUGER VOL 2 PG 387 STONE MON. 2443.32 TO STONE MON 1884 @ NE COR SEC 2, 2659.8 TO SE COR SEC 2, 2613.60 TO HH 20X14X9 SURROUNDED BY 4 HH @ CENTER OF SEC 2, & 5222.91 TO STONE MON. @ W 1/4 COR SEC 2
- SUNNY #5047 STATES NOTHING ABOUT MON. SHOWS E/W 1947 FENCE LINE & 2518.5 TO NORTH SEC LINE.
- BATTERMAN VOL 4 PG 36 RUGER MON. REFERERENCED 1959 SAME.
- NOTE ONLY IN BELOIT SET OF RECORDS. RESET 1" PIPE IN 1961 BLACKTOP.
- WILHELM #7008 CALLS FOR IRON PIPE @ CENTER OF SEC 2. 1975 FD 3/4 IP FROM COUNTY TIES. SO-00-02W 2665.99 TO COUNTY MON @ SE COR SEC 2 & NO-00-02E 2519.37 TO REBAR @ NE COR SEC 2
- 1975 WILHELM VOL 5 PG 161 FD 3/8 IP FROM COUNTY TIES. SO-00-02W 2665.99 TO COUNTY MON @ SE COR SEC 2 & NO-00-02E 2519.37 TO REBAR @ NE COR SEC 2

## FD PINCHED PIPE & REFERENCE PIPES.

C) Was the corner restored through acceptance of (1) an obliterated evidence location, or, (2) a found perpetuated location?

## ACCEPTED FD PERPETUATED LOCATION.

- D) Describe any material discrepancy between the location of the corner as restored or reestablished and the location of that corner as previously restored or reestablished by distance and direction. Show the discrepancy on the plan view drawing under (a), above. Show the distances between the corner as previously restored or reestablished and (1) the corner as restored or reestablished, and (2) to at least 4 of the witness monuments shown on the drawing in (a), above. NONE
- (E) Was the corner reestablished through lost corner proportionate methods? If so, show the method, including the directions and distances to other public land survey corners used as evidence or used for proportioning the corner location. No
- I, Donald Barnes, hereby certify that the corner location as identified by the corner code index was determined by me under my direction and control and that this U.S. Public Land Survey Monument Record is correct and complete to the best of my knowledge and belief.

SHEET 1 OF 2

CORNER CODE C-21

A.E. 7.08 REQUIREMENT

