Paper weight-110# (minimum)

Black nonfading ink required

## LAND U.S. PUBLIC SURVEY **MONUMENT RECORD**


For Public Land Survey Corners In:

WI ADMINISTRATIVE CODE A-E 7.08 REQUIREMENT

REV 10/23/2004 USMONREC.DWG

T. 4 N. R. 10 E. 4th P.M.

CORNER CODE INDEX

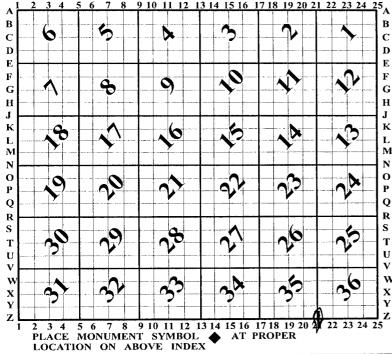

## **UNION TWP ROCK COUNTY WI**

IF AVAILABLE ROCK COUNTY COORDINATES PERFERRED

North	Elev.
East	<del></del>
Hor. Datum	Vert. Datum
LATITUDE	ELLIPS. HT
LONGITUDE	
NAD83(91)	NETWORK ADJ. YR 2010
GPS (X)	TRAVERSE (X) X
BASED ON THE	FOLLOWING CONTROL:

**◆ CORNER MONUMENT** 

WITNESS MONUMENT

(a) ROCK COUNTY PROJECTION BEARINGS ARE BASED ON:\_

SHOW A PLAN VIEW DRAWING DEPICTING THE CORNER MONUMENT AND SURROUNDING PHYSICAL FEATURES, INCLUDING THE EXCAVATION AREA AND DEPOSIT FIELD BOOK \_

PLANNING & ZONING COMMITTEE ADOPTED THIS FORM ON 12/2/1982

CORNER CODE 2-2/

## UN631 SECORSEC35

(B) Describe any record evidence, monument evidence, occupational evidence, testimonial evidence or any other material evidence you considered, and whether the monument was found or placed.

1833 BRINK & MULLETT (SEP12) T4N R10E VAR 8-15E

WEST PM ON SOUTH SIDE OF SECTION 36 (PG 1 07)

2640.00 SET QUARTER SECTION POST IN PRAIRIE AND MADE A MOUND

4554.0 LEAVE PRAIRIE

5280.0 SET POST FOR CORNER TO SECTIONS 35 & 36 BUR OAK 16 N44W 145.2'; BUR OAK 12 N37 12E 25.08'

LAND LEVEL SECOND RATE PRAIRIE LOW WILLOW GRASS G? & @ WEST OF PRAIRIE BURR OAK & RED ROOT GRASS

1833 BRINK & MULLETT (SEP 12) T4N R10E

WEST ON SOUTH SIDE OF SECTION 35 (PG107)

1351.02 BURR OAK 16

2640.00 SET QUARTER SECTION POST BURR OAK 10 N53E 52.80', BURR OAK 10 N3O 1/2W 64.68'

3079.56 BURR OAK 10

5016.00 ENTER MARSH OR CREEK BOTTOM

5280.00 SET POST FOR CORNER TO SECTIONS 34 & 35. BURR OAK 8 N19W 110.88', BURR OAK 14 151.14'. LAND ROLLING SECOND RATE BURR OAK ? OAK HIGH RED ROOT.

1833 HARRISON (DEC 2) NORTH BET. SECS 1& 2 T3N R10E

1958.88 BURR O. 12

2640.00 SET QUARTER SEC. COR. BEARING {RED 0 10 N85E 264 BURR 0 10 N15W 330 RED 0 10; BURR 0 10} MARKED

4894.56 INT. N. BDY AT POST {BURR O 12 SBW 54.12 BURR O 12 S50E 77.88 LAND LEVEL 2ND RATE TIMBER ALL BURR O OF A DWARF CHARACTER. DEC 2ND 1833 GEO. W. HARRISON

1833 HARRISON (NOV 5TH) NORTH BETWEEN SECS 35 & 36 VAR 8-15E

2640.00 SET CORNER TO QUARTER SEC {BURR O 10 S33W 49.55'; BURR O 10 S65E 40.26' BURR O 10 & BURR O 10 MARKED

4950.0 ENTER PRIAIRE

5280.00 SET COR TO SECS 25,26,35, & 36 {BURR O 10 N75W 162.36' BURR O 18 S66W 217.8' NOT OTHERS CONVENENT LAND LEVEL 2ND RATE TIMBER ?? BURR O. ?? GRASS & WEEDS.

1856 MAGNOLIA TWP RD BK 1 PG 18 A HIGHWAY BE LAID OUT IN SAID TOWN OF THE WIDTH OF FOUR RODS, AND CAUSED A SURVEY, THEREOF TO BE MADE AS FOLLOWS; BEGINNING NEAR THE NE CORNER OF SEC 2 IN SAID TOWN RUNNING THENCE WEST ALONG THE NORTH LINE OF SAID SEC 2, TO THE ROAD LEADING FROM MAGNOLIA TO EVANSVILLE, THE WHOLE WIDTH OF FOUR RODS IN MAGNOLIA.

1867 LOCKE VOL 1 PG 301 FD STUMP OF NW BT & OLD STAKE SET BR. O. STAKE WITH SMALL LIMESTONE ON S & W AND
SMALL HH N & E & LARGE HH ON W IN MOUND. VAR 6-55
2621.19 TO S 1/4 COR SEC 36 & VAR 6-55 5242.38 TO SE
COR SEC 36.

SEAL

SHEET 1 OF 4

CORNER CODE m Z-21

Sep 2, 2011

LOCKE VOL 1 PG 303 & #5277 SEE SEC 36. VAR 7-25 1867 2628.12 TO S 1/4 COR SEC 35 & VAR 7-25 5256.24 TO SW COR SEC 35. RUGER AUG 17 REMON-62 WEST ON SOUTH LINE OF SE 1/4 1870 SEC 35 ON A VAR 7-20 OFFSET SOUTH 26.40' OFFSET NORTH 29.7' AT 2632.74 INTERSECTED QUARTER LINE 0.66' SOUTH OF QUARTER CORNER FOUND POST SURROUNDED BY STONES SET BY LOCKE AT CORNER. COR VAR 7-15 WEST ON SOUTH LINE OF SW 1/4 SEC 35 ON A VAR 7-20 OFFSET NORTH 18.81' AT 2631.42 INTERSECTED WEST BOUNDARY LINE 13.20' NORTH OF CORNER. FOUND FENCE POST ON CORNER ALSO EAST BEARING TREE AND STUMP OF WEST BEARING TREE. COR VAR 7-13 1870 RUGER AUG REMON-61 EAST ON SOUTH LINE OF SW 1/4 SEC 36 ON A VAR 6-50 OFFSET NORTH 7.92' AT INTERSECTED QUARTER LINE 16.5' NORTH OF 2626.8 QUARTER CORNER, FOUND STAKE SET BY LOCKE AT COR. **COR VAR 6-39** EAST ON SOUTH LINE OF SE 1/4 SEC 36 ON A VAR6-10 OFFSET SOUTH 1.98' AT INTERSECTED EAT BOUDARY LINE 6.6' 2625.15 SOUTH OF CORNER. FOUND STAKE SET BY LOCKE AT CORNER. COR. VAR 6-16 RUGER AUG REMON-60 SOUTH ON WEST LINE OF NW 1/4 1870 SEC 36 ON A VAR 7-00 OFFSET EAST 3.3' OFFSET WEST 11.22' AT INTERSECTED QUARTER LINE 6.6' WEST OF 2652.54 QUARTER COR. FOUND STAKE SET BY LOCKE AND REMAINS OF BOTH STUMPS OF BEARING TREES.COR VAR 6-58 SOUTH ON WEST LINE OF SW 1/4 SEC 36 ON A VAR 6-30 AT INTERSECTED SOUTH BOUNDARY LINE 11.22' 2653.20 WEST OF CORNER. FOUND STAKE SURROUNDED BY STONES SET BY LOCKE AT COR. FOUND STUMP OF NW BEARING TREE AND WHERE STUMP OF NE BEARING TREE HAD BEEN DUG UP. COR VAR 6-45 BARNES VOL 5 PG 410 DUG & FD CUT LIMESTONE 1' DEEP. 1978 PLACED IP HORIZONTALLY NEXT TO STONE. REF SAME. STONE IS 2' EAST OF N/S FENCE LINE & ON LINE WITH E/W **FENCE LINE** CSM VOL 9 PG 128 FD STONE MON. CSM IN 1979 ANDERSON SEC 1 MAGNOLIA TWP. BARNES VOL 6 PG 27 FD CUT LIMESTONE. 277,293.9X; 1980 2,196,232.2X. S89-36-3E 2626.51 TO S 1/4 COR SEC 36, NO-11-08W 2654.94 TO CUT LIMESTONE @ W 1/4 COR SEC 36, SO-35-09E 2276.65 TO FD ALUM MON @ W 1/4 COR SEC 1. LAT 42-45-39 LONG 89-16-10 BARNES VOL 6 PG 440 STATES NOTHING ABOUT MON. S89-1994 36-51E 2626.51 TO FD ALUM @ 5 1/4 COR SEC 36, NO-11-04W 2655.13 TO W 1/4 COR SEC 36, SO-35-09W 2276.66 TO FD ALUM @ W 1/4 COR SEC 1

World Paines Emboss Paines Sep 2, 20//

SHEET 2 OF 4

CORNER CODE Z-21

UN631

SECORSEC35

## UN631 SECORSEC35

2007 COMBS CSM VOL 31 PG 86 LS S89-41-42W 2634.44 TO LS @ S 1/4 COR SEC 35

FD CUT LIMESTONE 0.3' DEEP WITH R/R SPIKE ON NORTH EDGE.
PLACED 2 MAGNETS ON WEST SIDE OF L.S. LS IS 2.7' EAST OF N/S
FENCE LINE & 1.4' NORTH OF E/W FENCE LINE. SET CARSONITE
POST IN N/S FENCE LINE & OPPOSITE OF L.S. FD 2 REFERENCE
PIPES. CORNER IS ALSO THE NE COR OF SEC 2 MAGNOLIA TWP.

C) Was the corner restored through acceptance of (1) an obliterated evidence location, or, (2) a found perpetuated location?

ACCEPTED FD LS.

D) Describe any material discrepancy between the location of the corner as restored or reestablished and the location of that corner as previously restored or reestablished by distance and direction. Show the discrepancy on the plan view drawing under (a), above. Show the distances between the corner as previously restored or reestablished and (1) the corner as restored or reestablished, and (2) to at least 4 of the witness monuments shown on the drawing in (a), above.

NONE

(E) Was the corner reestablished through lost corner proportionate methods? If so, show the method, including the directions and distances to other public land survey corners used as evidence or used for proportioning the corner location.

NΠ

I, **Donald Barnes**, hereby certify that the corner location as identified by the corner code index was determined by me under my direction and control and that this U.S. Public Land Survey Monument Record is correct and complete to the best of my knowledge and belief.

SHEET 3 OF 4

Sep 2,2011

CORNER CODE Z-21

A.E. 7.08 REQUIREMENT

