

U.S. PUBLIC LAND SURVEY MONUMENT RECORD


For Public Land Survey Corners in the
T. 2N., R. 12E.

CORNER CODE INDEX

| | | | | | | | | | | | | | | | | | | | | | | | | | |
|---|---|---|---|---|---|---|---|---|---|----|----|----|----|----|----|----|----|----|----|----|----|----|----|----|----|
| | 1 | 2 | 3 | 4 | 5 | 6 | 7 | 8 | 9 | 10 | 11 | 12 | 13 | 14 | 15 | 16 | 17 | 18 | 19 | 20 | 21 | 22 | 23 | 24 | 25 |
| A | | | | | | | | | | | | | | | | | | | | | | | | | |
| B | | | | | | | | | | | | | | | | | | | | | | | | | |
| C | 6 | | | | | | | | | | | | | | | | | | | | | | | | |
| D | | 5 | | | | | | | | | | | | | | | | | | | | | | | |
| E | | | 4 | | | | | | | | | | | | | | | | | | | | | | |
| F | | | | 3 | | | | | | | | | | | | | | | | | | | | | |
| G | | | | | 2 | | | | | | | | | | | | | | | | | | | | |
| H | | | | | | | | | | | | | | | | | | | | | | | | | |
| I | | | | | | | | | | | | | | | | | | | | | | | | | |
PLACE MONUMENT SYMBOL (◆) AT PROPER LOCATION ON ABOVE INDEX

EXAMPLE

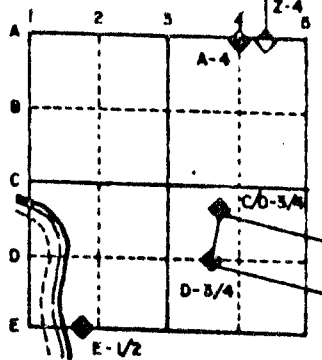


ROCK TWP
ROCK COUNTY WI

IF AVAILABLE
STATE PLANE COORDINATES

North (Y) _____ Eleve. (Z) _____
 East (X) _____ Zone _____
 Hor. Datum _____ Vert. Datum _____

◆ CORNER MONUMENT ○ WITNESS MONUMENT

BEARINGS ARE BASED ON: TWP PROTECT

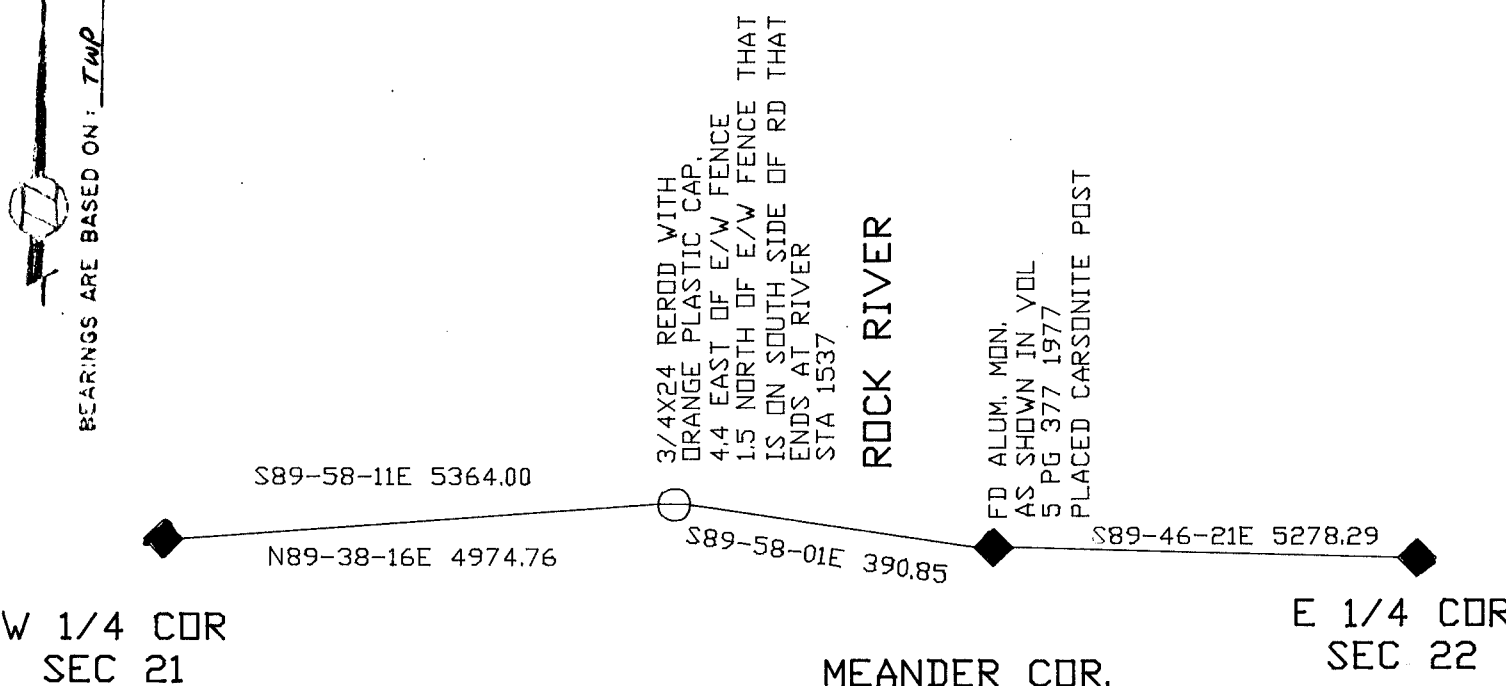

RECORDED

SHEET ___ OF ___

CORNER CODE: P13

(B) Describe any record evidence, monument evidence, occupational evidence, testimonial evidence or any other material evidence you considered, and whether the monument was found or placed.

1834 HARRISON. ORIGINAL GOVERNMENT SURVEYOR. FIELD NOTES -
3630 LEAVE RIVER. SET MEANDER POST ON RIGHT BANK.

BUR O 10 N 82 W 58.08

BUR O 12 S 36 W 41.58

1963 SHIMEALL PLAT OF SURVEY. STATES THAT HE FOUND A 6X12X12
STONE SURROUNDED BY LIMESTONES.

1977 BARNES VOL 5 PG 377 FOUND 6X10X12 HH SURROUNDED BY 4
LIMESTONES. REPLACED HH WITH ALUMINUM MONUMENT AND PLACED
R/W POST NEXT TO MONUMENT.

FOUND ALUMINUM MONUMENT AND R/W POST. PLACED CARSONITE POST NEXT
TO MONUMENT.

(C) Was the corner restored through acceptance of (1) an
obliterated evidence location, or, (2) a found perpetuated
location?

ACCEPTED FOUND PERPETUATED MONUMENT.

(D) Describe any material discrepancy between the location of the
corner as restored or reestablished and the location of that
corner as previously restored or reestablished by distance and
direction. Show the discrepancy on the plan view drawing under
(a), above. Show the distances between the corner as previously
restored or reestablished and (1) the corner as restored or
reestablished, and (2) to at least 4 of the witness monuments
shown on the drawing in (a), above.

(E) Was the corner reestablished through lost corner
proportionate methods? If so, show the method, including the
directions and distances to other public land survey corners used
as evidence or used for proportioning the corner location.

I, Donald Barnes, hereby certify that the corner points as
identified by the corner code index were, in a field survey on,
Oct 4 1990, established, re-established,
monumented, re-monumented, recovered or restored as expressed
below and in conformance with the regulations and rules as
required in the current manual of survey instructions of the
United States Department of Interior, Bureau of Land Management.

seal

Donald Barnes

COUNTY SURVEYOR FILING DATA

Date of computer entry _____

Date microfilmed _____

Number of included sheets _____
CORNER CODE

AFFIX YOUR LAND SURVEYOR SEAL

P13