


U.S. PUBLIC LAND SURVEY MONUMENT RECORD

For Public Land Survey Corners in the
T. 2 N., R. 12 E.

CORNER CODE INDEX

	1	2	3	4	5	6	7	8	9	10	11	12	13	14	15	16	17	18	19	20	21	22	23	24	25
A																									
B																									
C	6																								
D		5																							
E			4																						
F				3																					
G					2																				
H	7																								
I		8																							
J			9																						
K				10																					
L					11																				
M	16																								
N		17																							
O			18																						
P				19																					
Q	19				20																				
R		20				21																			
S			21				22																		
T				22				23																	
U					23				24																
V						24																			
W							25																		
X	30							26																	
Y		29							27																
Z			28							28															
				27							26														
					26							25													
						25							24												
							24							23											
								23							22										
									22							21									
										21							20								
											20							19							
												19							18						
													18							17					
														17							16				
															16							15			
																15							14		
																	14							13	
																		13							12
																			12						
																				11					
																					10				
																						9			
																							8		
																								7	
																									6
																									5
																									4
																									3
																									2
																									1

EXAMPLE

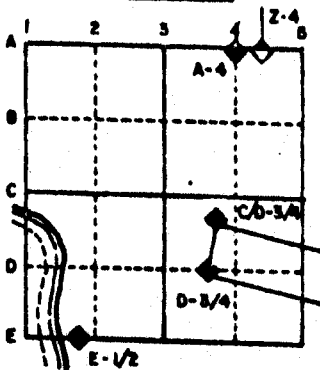

ROCK TWP
ROCK COUNTY WI

IF AVAILABLE
STATE PLANE COORDINATES



North (Y) _____ Eleve. (Z) _____
 East (X) _____ Zone _____
 Hor. Datum _____ Vert. Datum _____

PLACE MONUMENT SYMBOL (◆) AT PROPER
LOCATION ON ABOVE INDEX




e.)

◆ CORNER MONUMENT
placed ALUMINUM

○ WITNESS MONUMENT

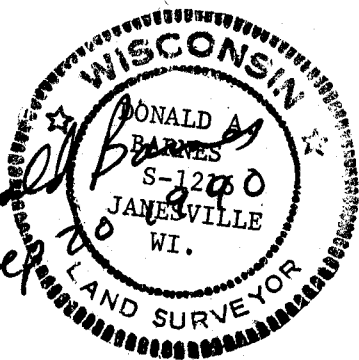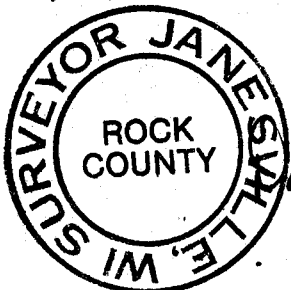

S. RIVER RD.

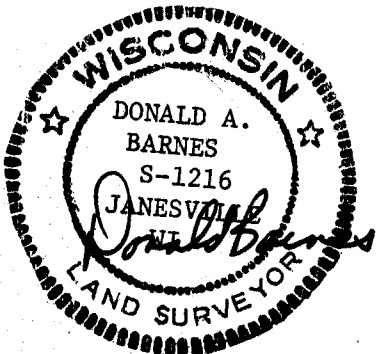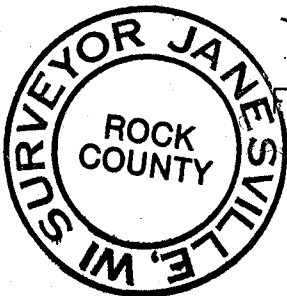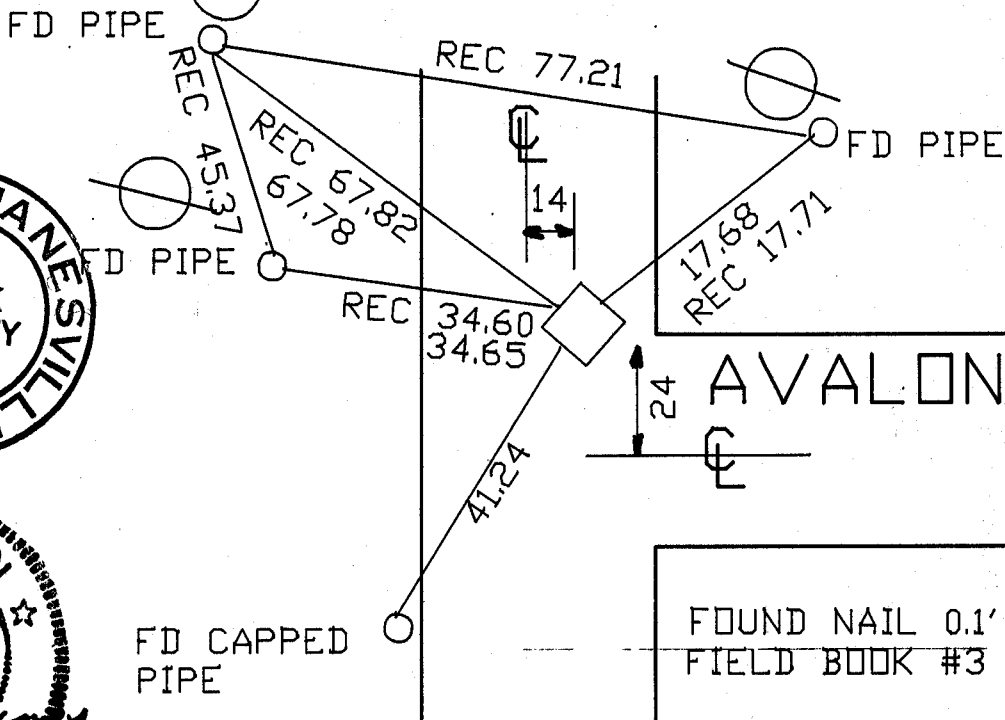

FOUND NAIL 0.1' DEEP
FIELD BOOK #3 PG 15, 35

MICROFILMED

SHEET ___ OF ___

CORNER CODE: L 14-15