



Found monument set by Locke
 Found flag hole set at ea. by Locke in Plym. Survey also found checker set by Locke

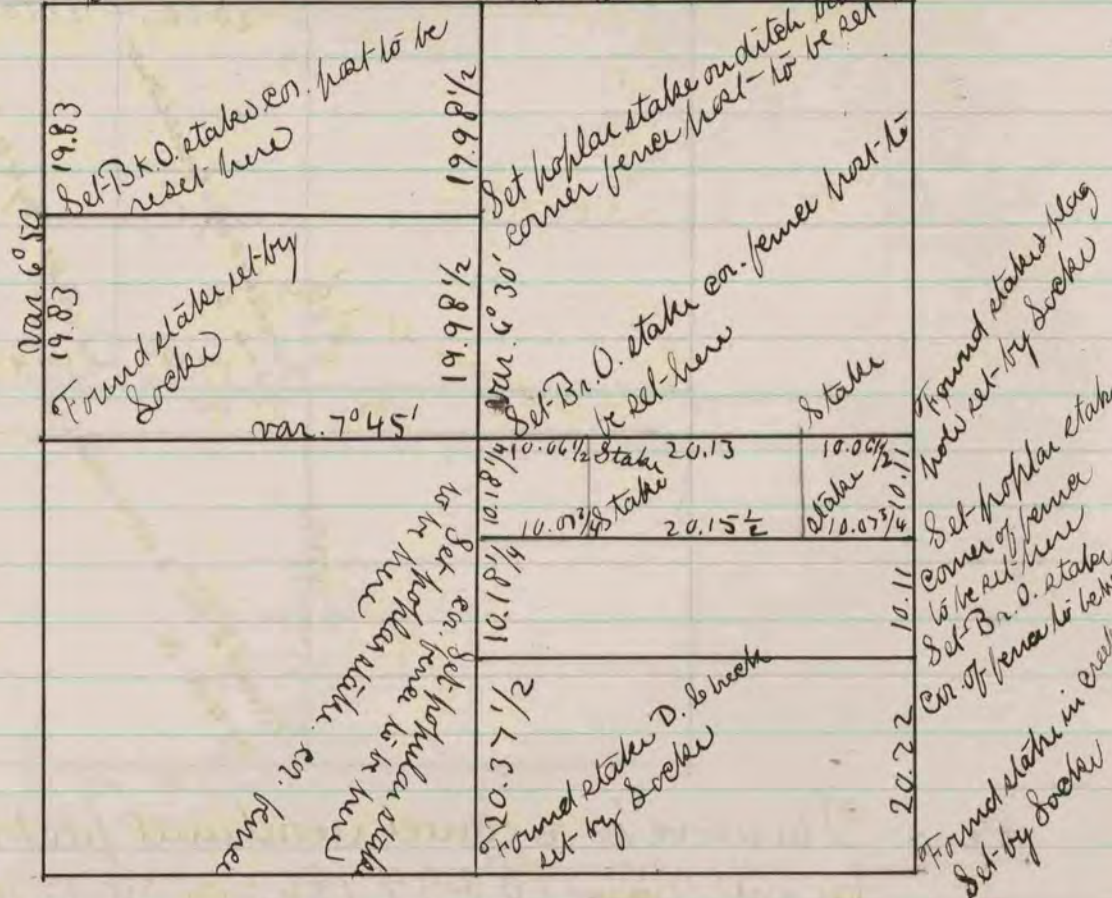

The above is a correct record and plat of a survey made by me Nov. 17. 18. 19. 1868. on Sec 18. T. 2. R. 11. (Plymouth)
 P. K. Lee. Dep. Co. Surveyor

Found monument set short stakes with some markers Found Mon.

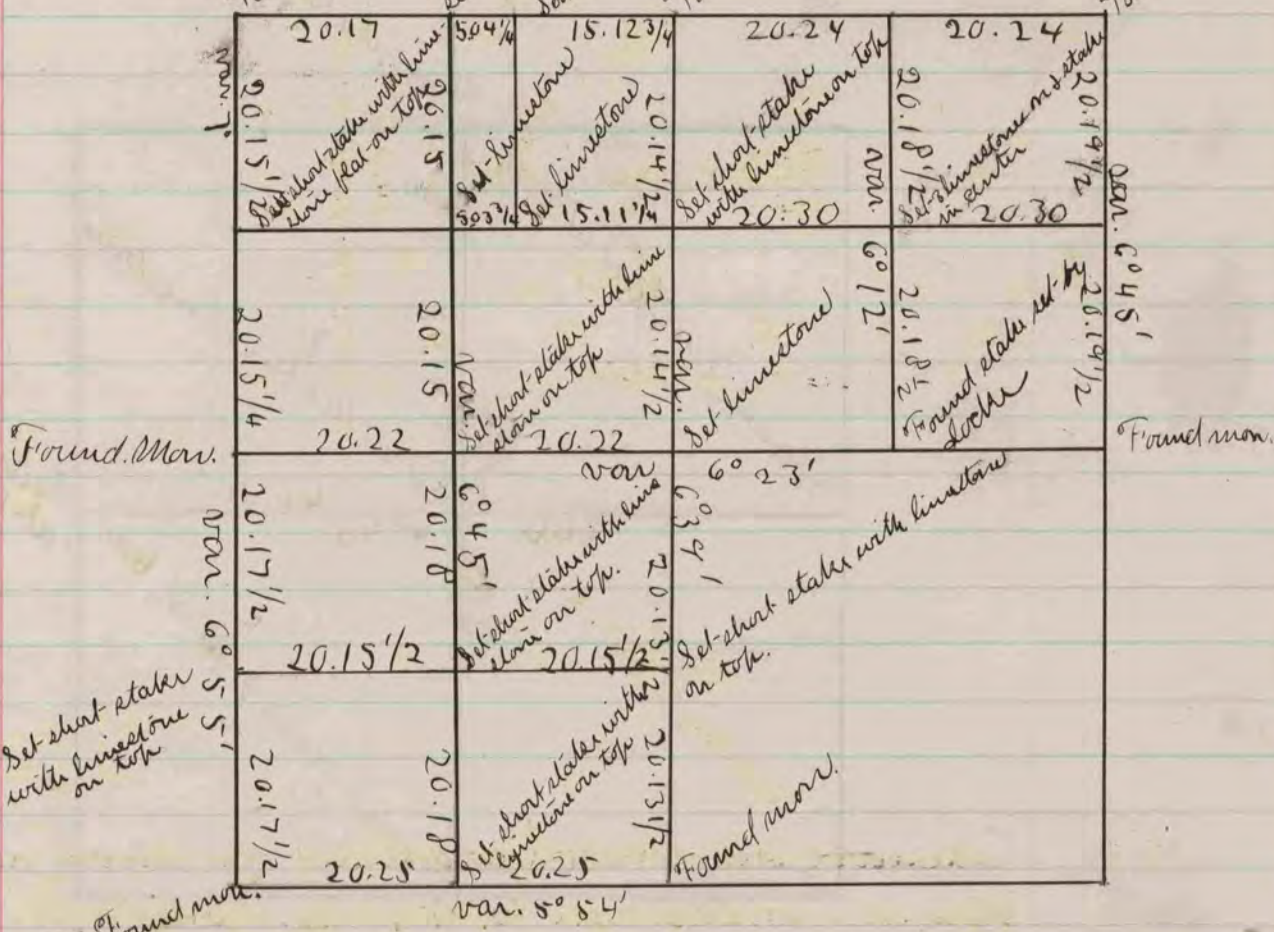

The above is a correct record and plat of a survey made by me March 15, & 16. 1869. on Sec 26. T. 2. R. 11. (Plymouth)
 P. K. Lee
 Dep. Co. surveyor

COUNTY SURVEYOR
 RECORD 1859-1906