


Below is a correct Record & Plot of a survey made
 by me April 5th & 6th 1869 on Sec. 35 T. 1 R. 11 (Newark)
 R. K. Lee Dep. Co. Surveyor

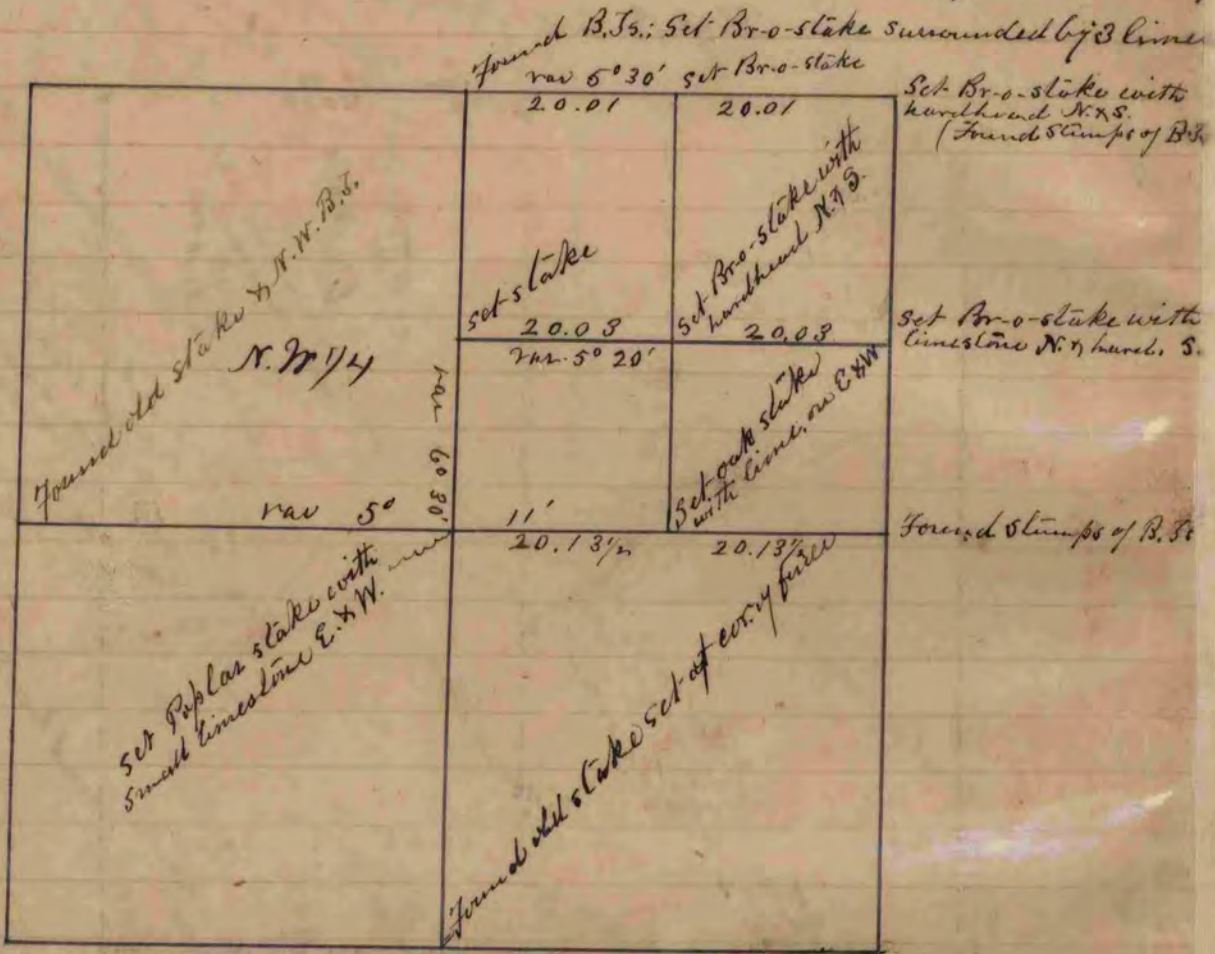

The above is a correct Record and Plot of a Survey made by me April 9th 1869 on Sec. 15 T. 3. R. 12 (Janesville)
 R. K. Lee Dep. Co. Surveyor