



Below is a correct Record & Plat of a Survey made by me May 10<sup>th</sup> 1869 on Sec. 6. T. 2 R. 13 (La Prairie) R. K. Lee Dep. Co. Surveyor

Found stake set by Ranger see page 126

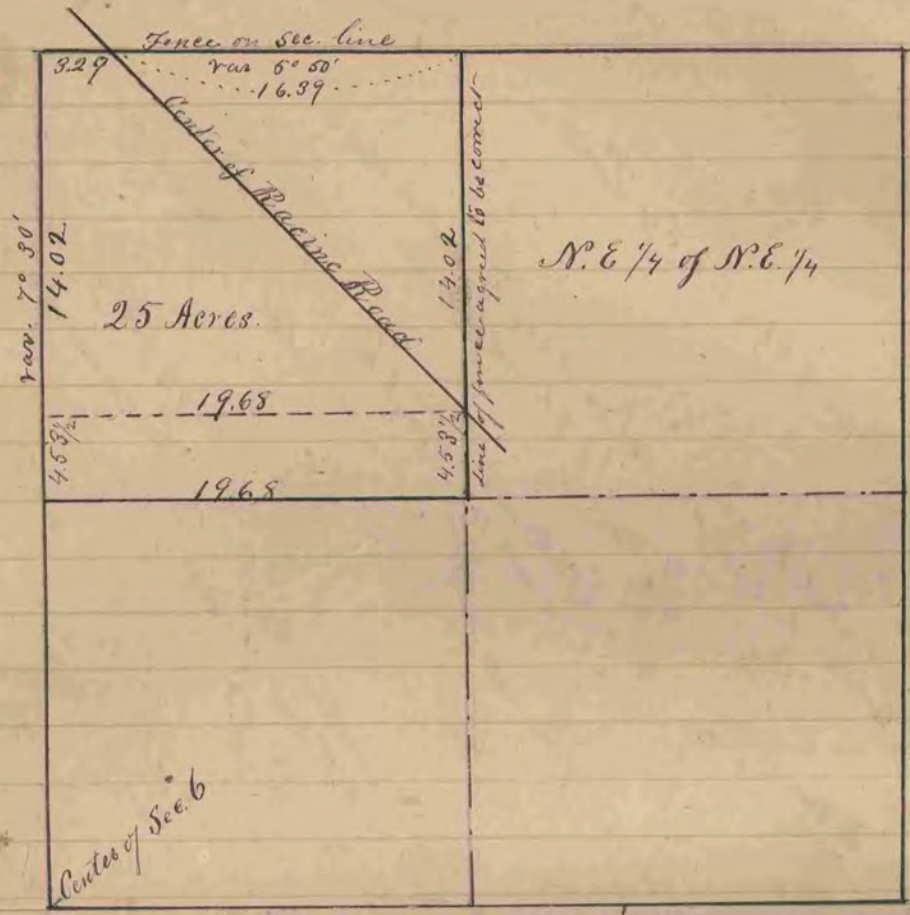

COUNTY SURVEYOR  
RECORD 1 1851-1869

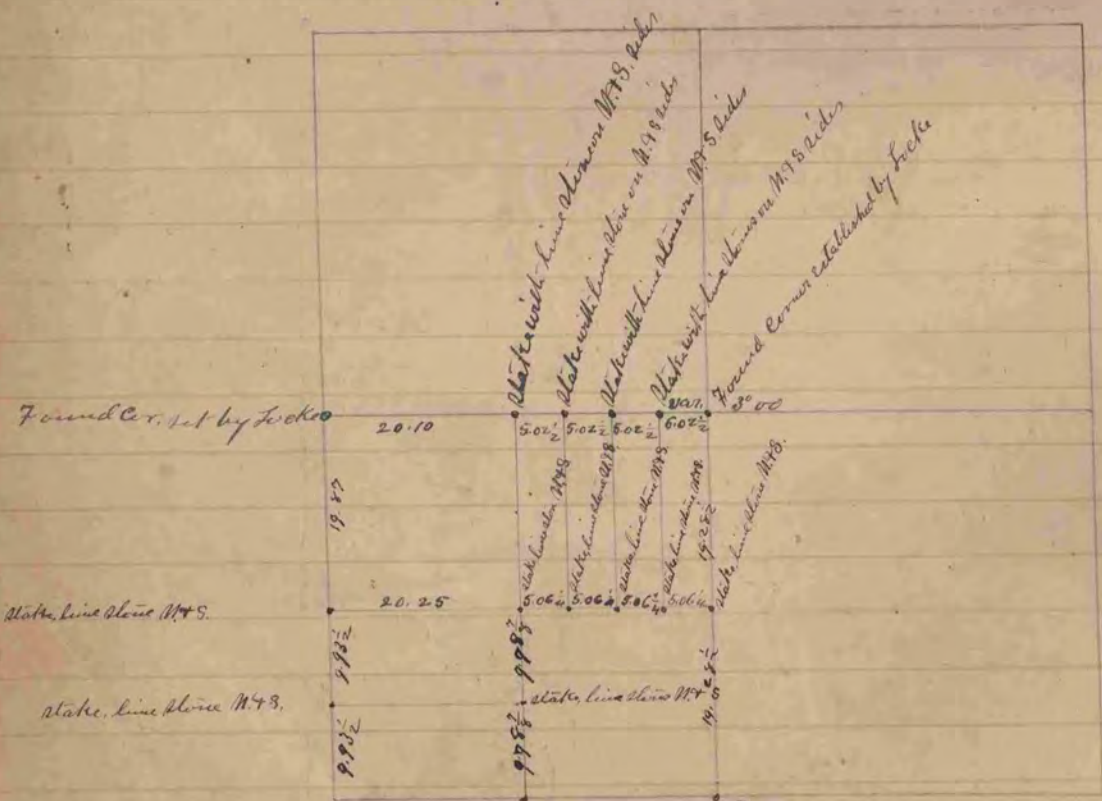

The above is a correct Record & Plat of Survey made by me May 19 - 1869 on Section 1 Spring Valley R. K. Lee