



Found stump of B.P. & remnant
of old stake
Set stake with large h. h. on
E & W. & smaller on N & S.

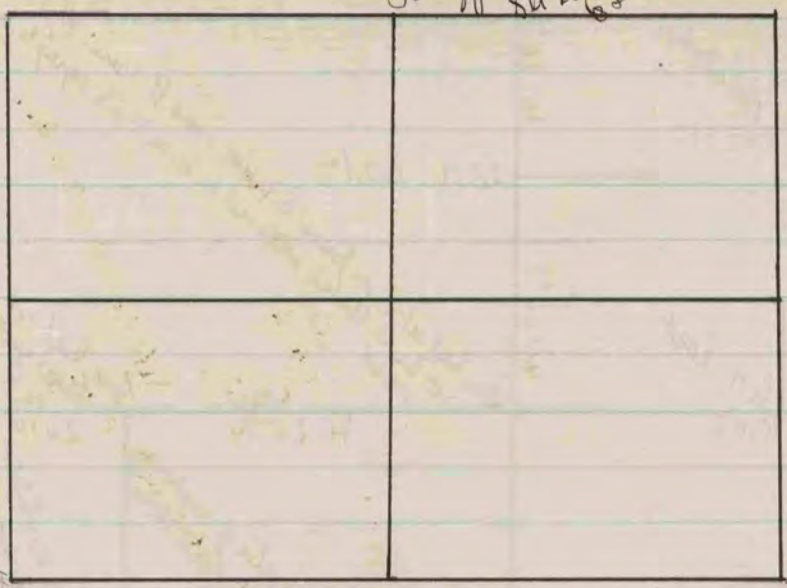

The above is a correct record and plat of a survey made by me Sept. 20. 1866. on Sec. 27. Union
J. S. Locke Co. Surveyor.

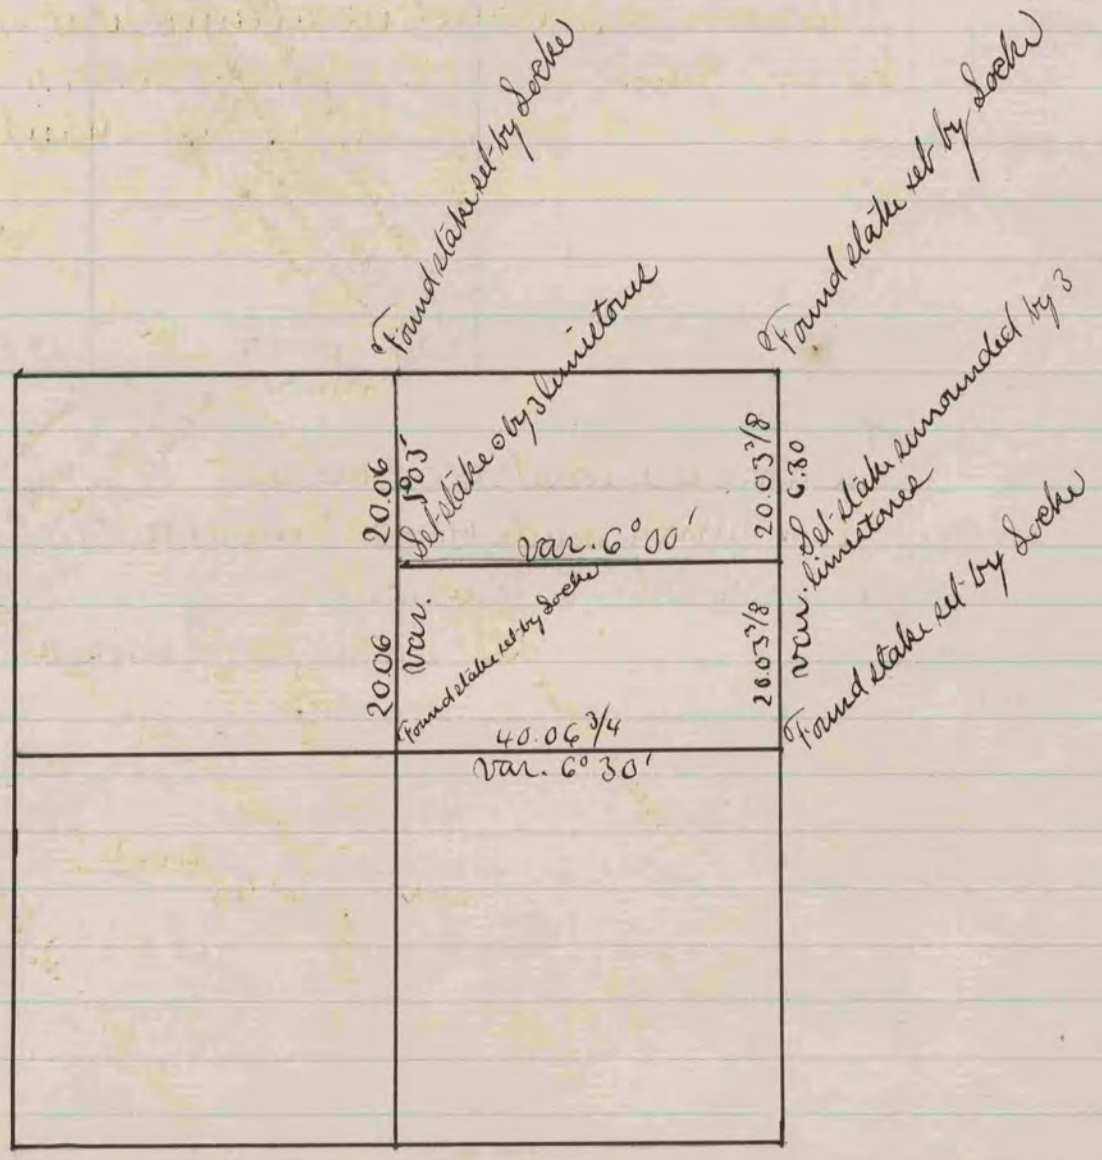

The above is a correct record and plat of a survey made by me June 20. 1867, ^{Sec 12} T. 2 R. 11. E. Plymouth
P. A. Lee Deputy, Co. Surveyor

COUNTY SURVEYOR
RECORD 1859-1906

COUNTY SURVEYOR
RECORD 1859-1906