


The above is a correct Record & Plat of a survey made by me
 June 7, 1866 on Sec. 15, Lima S.D. Locker Co. Surveyor

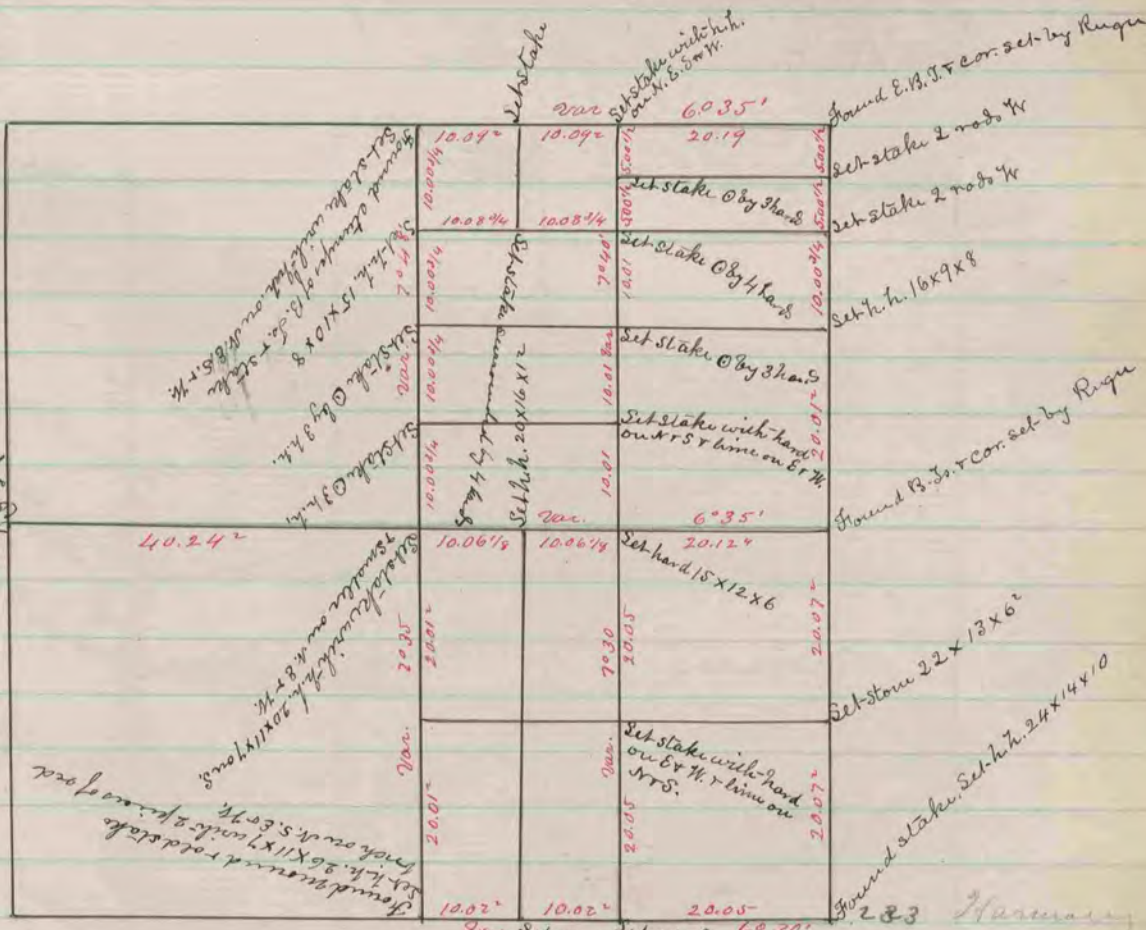

The above is a correct Record & Plat of a
 Survey made by me June 9-13 1866 on Sec. 15, Harmony
 S.D. Locker Co. Surveyor