



Found Old stake & stone

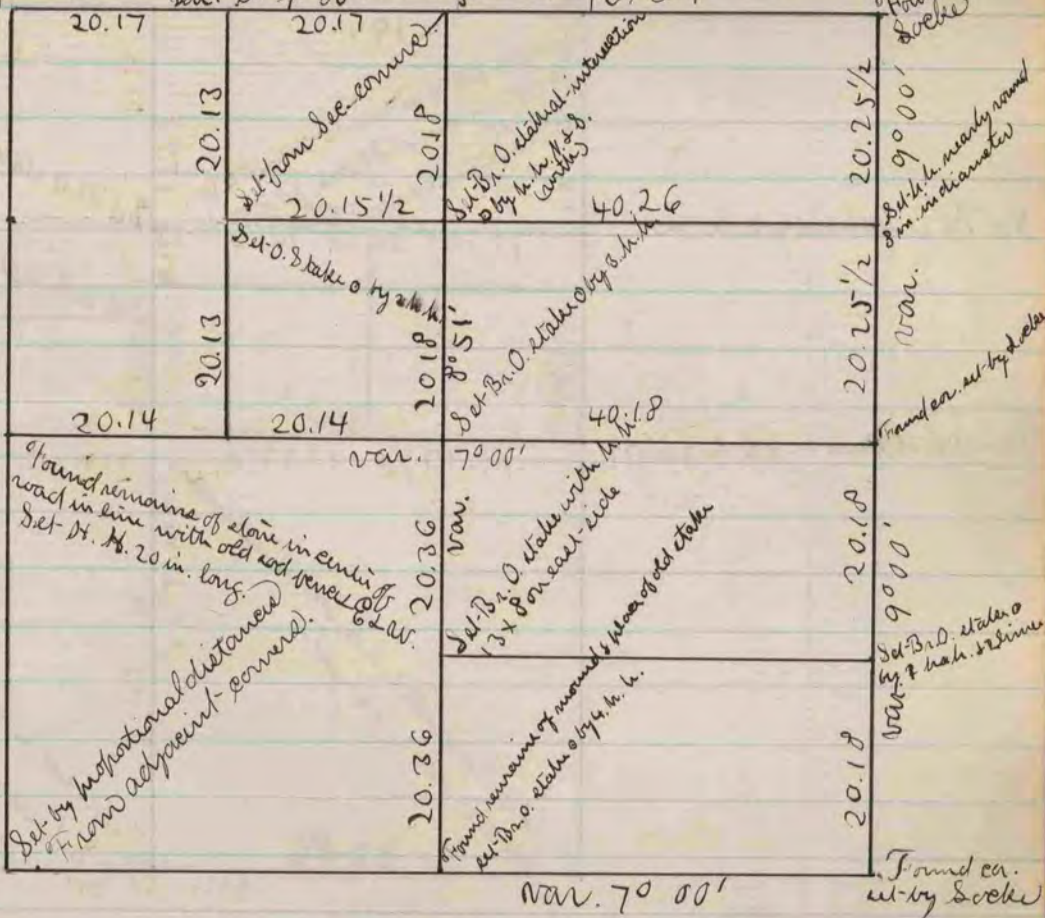

The above is a correct record and plat of a survey made by me June 7th 1869. On Sec. 27, T. 3, R. 10 (Magnolia)
R. A. Sewell, Co. Sur.

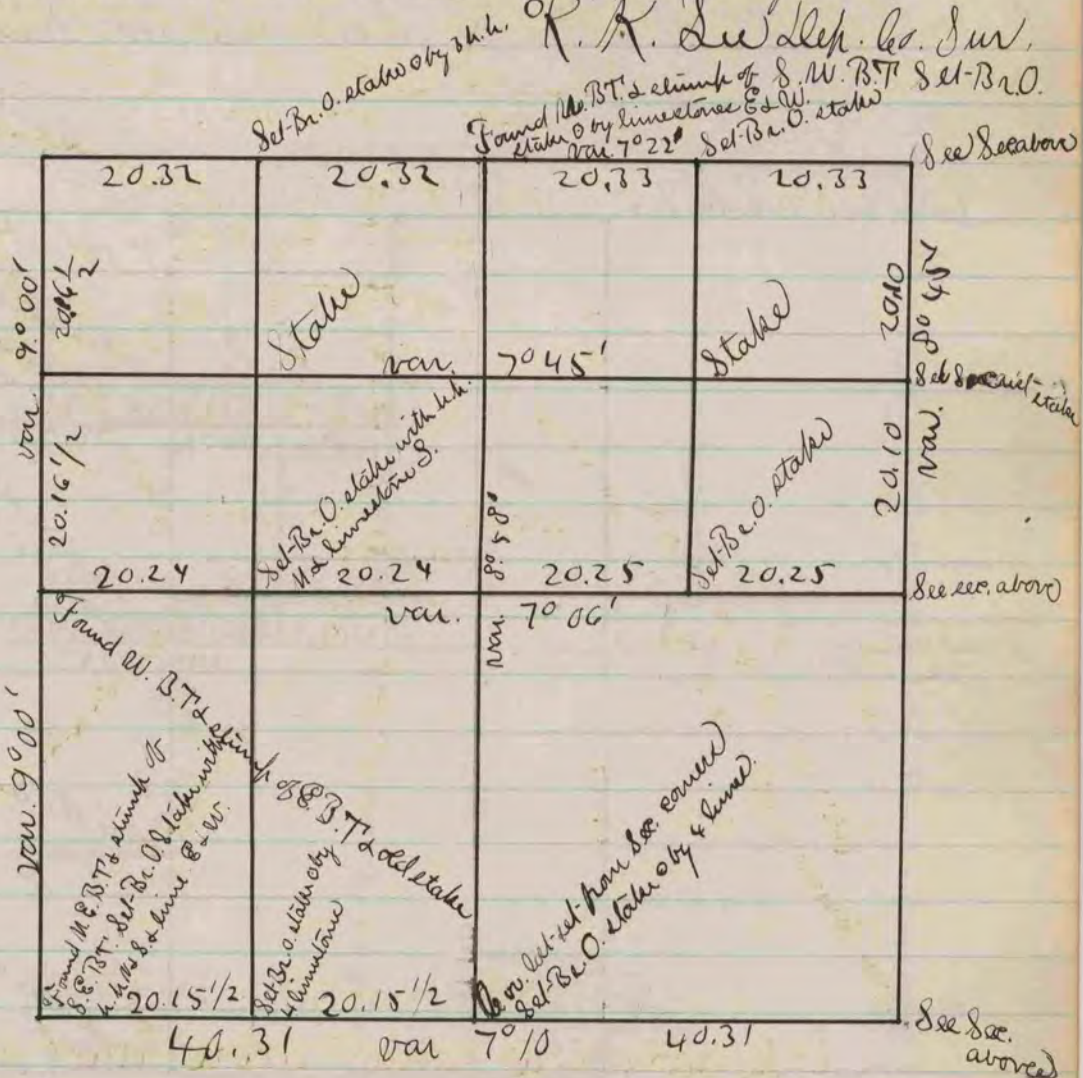

The above is a correct record and plat of a survey made by me July 8 & 9, 1869. on Sec. 28, T. 2, R. 10 (Magnolia)
R. A. Sewell, Co. Surveyor