


Found N.B. I. old stake set stake on N.S.  
 Var. S. B. O. stake mid-hand 10x12x8 on W.  
 Found N.B. I. Set Br. O. stake deep with limestone 12 1/2 x 7 1/2 x 6 on it  
 Set stake with h.h. on N.S. & W. in mound  
 Set stake with limestone on N.E. & W. & h.h. on S.  
 This distance of N.B. I. 82 1/2 instead of 32 1/2 as in  
 Found N.B. I. Took N.B. I. Br. O. 13 N. 5 8° 30' W. 19  
 Set stake with limestone on N.S. & W.  
 Found Br. of iron & stone set by Reyer  
 4 lime stones on N. S. & W.  
 Found old stake in center of highway  
 Set W. O. stake with h.h. on S & limestone on N. & W.

Record & Plat of a survey made on Sec. 24 T. 2. R. 13. E.  
 June 2 & 3 1864 by S. H. Locke Co. Surveyor Harmony

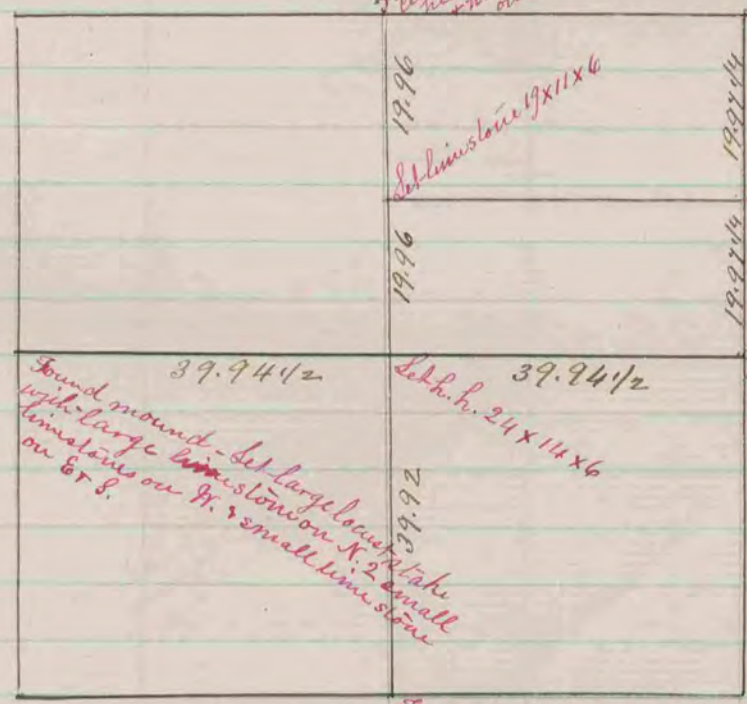

Found old stake in center of highway  
 Set W. O. stake with h.h. on S & limestone on N. & W.  
 Found mound fence post on cor. set limestone on N. & W.  
 Set h.h. 19x17 1/2 x 7 1/2  
 Found old stake & mound, set Br. O. stake with red hand on N. & limestone on S.  
 Found mound - set large limestone on N. & small limestone on S.  
 Set large limestone on N. 2 small limestone

Record & Plat of a survey made on Sec. 27 T. 2. N. R. 13. E. June 4, 1864. by S. H. Locke Co. Surveyor La Prairie

COUNTY SURVEYOR  
 RECORD 1859-1906