


Johnstown A Record Plat of a survey made on Dec. 20 73
R 14 by Edward Rizer Co. Surveyor

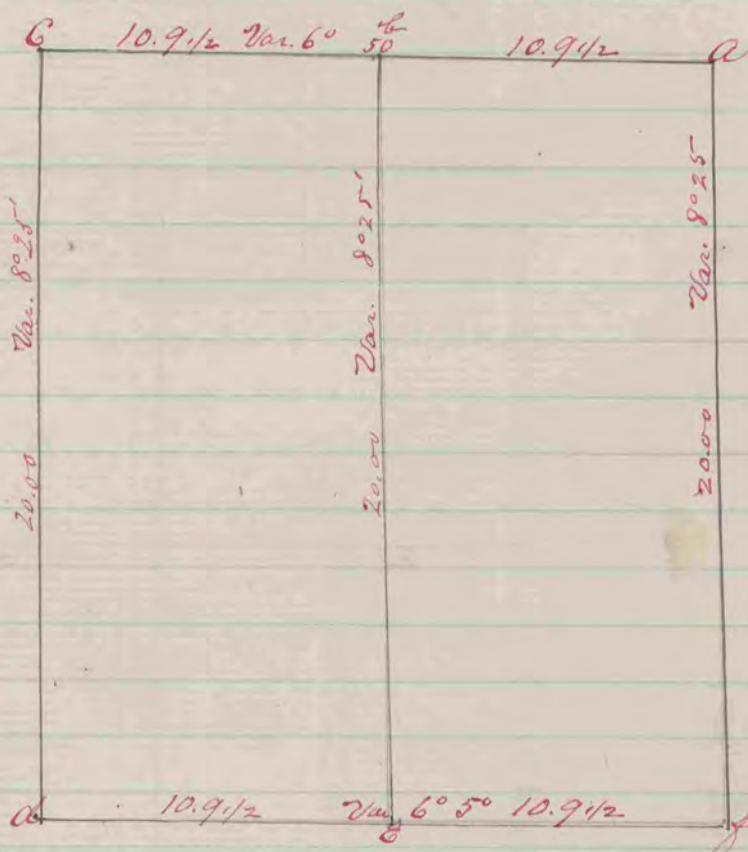

- At "a" Set stake with 3 stones near surface surrounding stake
- "b" " " " " " " " " " "
- "c" " " " " " " " " " "
- "d" Burr Oak 14 inches 3.30 E. 45 links
- "e" found original Post = S. W. cor. of Sec.
- "f" Set stake with 3 stones near surface surrounding stake
- "g" White Oak 24 inches - on corner

Feb 23 1863
 Record Plat of a survey made by S. W. Lockman Sec. 27 31 R 14 E