


The above is a correct record & plat of a survey made by me Nov. 28 & 29, 1866, on Sec. 6 Town of Clinton S. H. Locke Co. Surveyor.

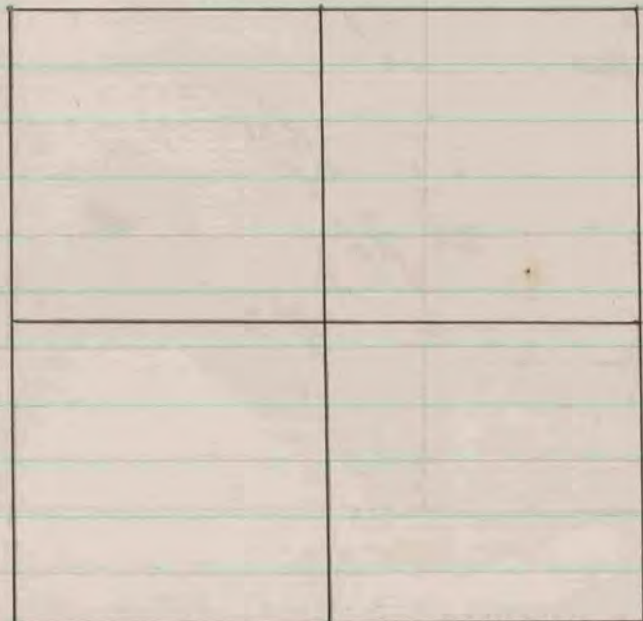

Found stump of M. B. J. T. when E. B. J. was dug out - old stake - set stake with flat limestone on N. S. E + W.

The above is a correct record & plat of a survey made by me Nov. 29, 1866, on Sec. 35 Town of Clinton S. H. Locke Co. Surveyor.