


The above is a plat and record of a survey made by me May 11 & 12th 1870. on Sec. 6. above.

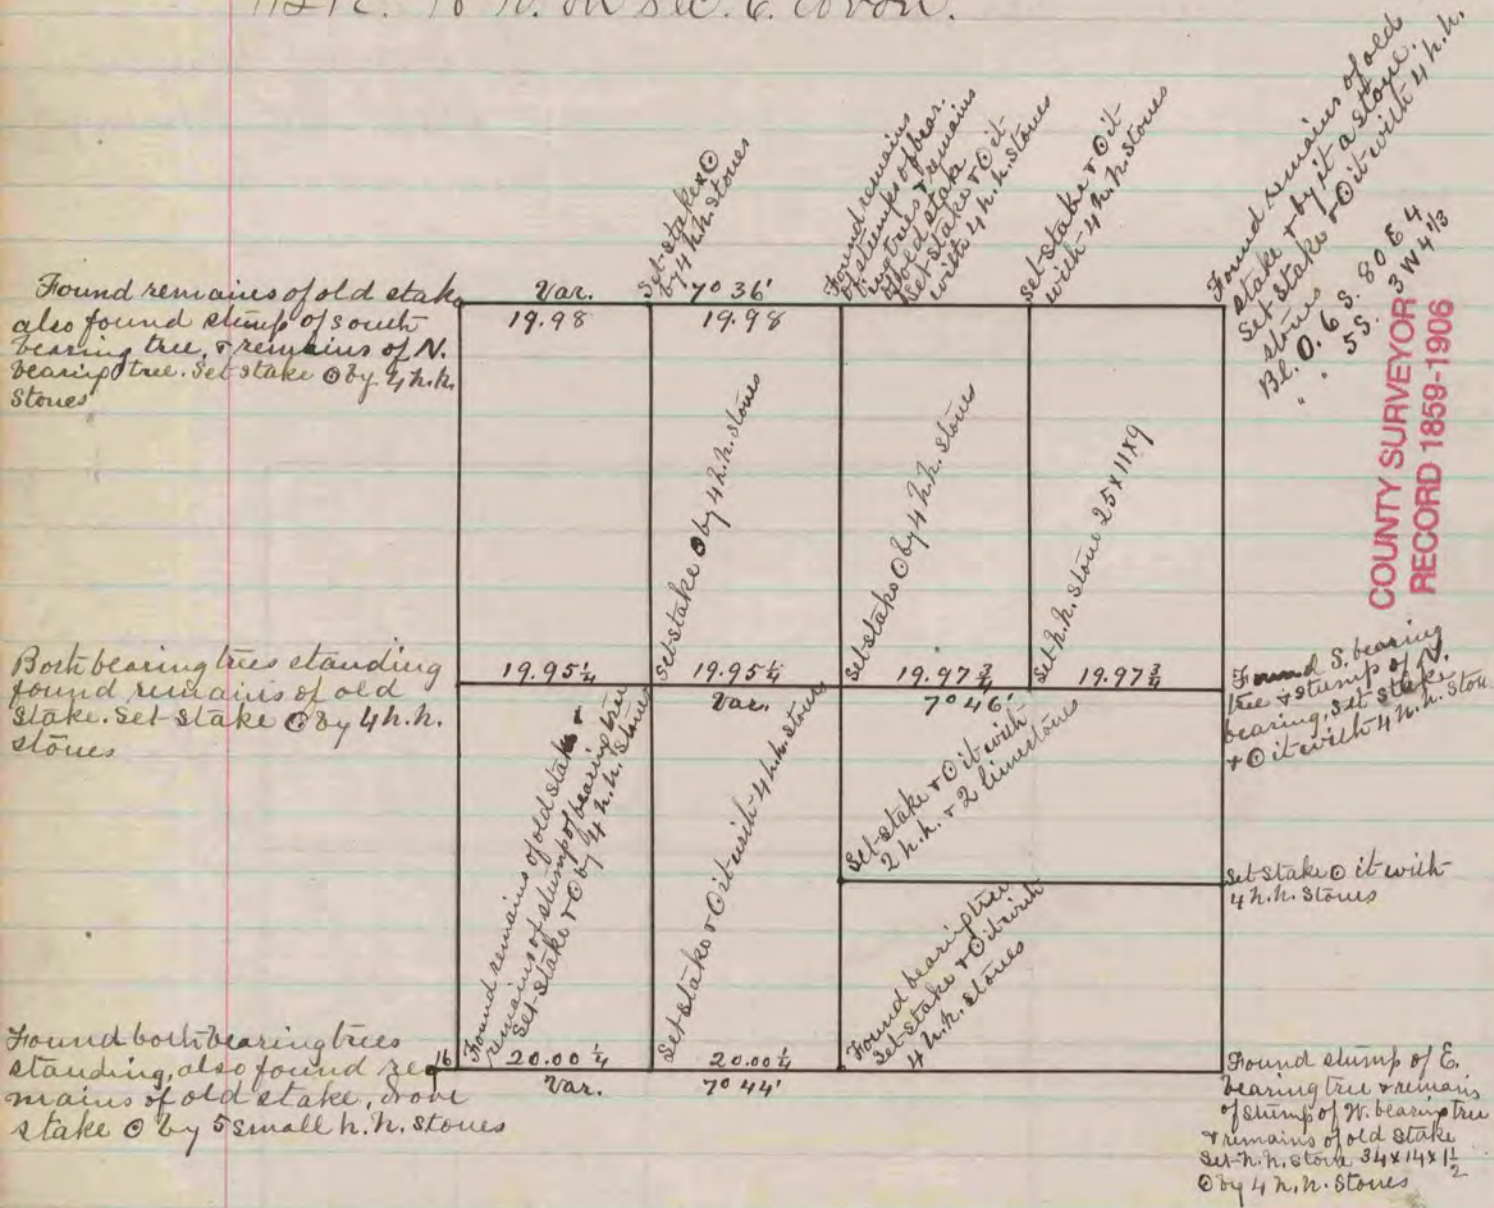

The above is a correct Record & Plat of a survey made by me May 17 & 18 - 1870 on Section 33 Fulton Edward Regu Dept. Co. Surveyor