


The above is a correct record and plat of a survey made by me Dec. 13. 1869. on Sec. 2. Harmony R. R. Sec. Dep. Co. Surveyor.

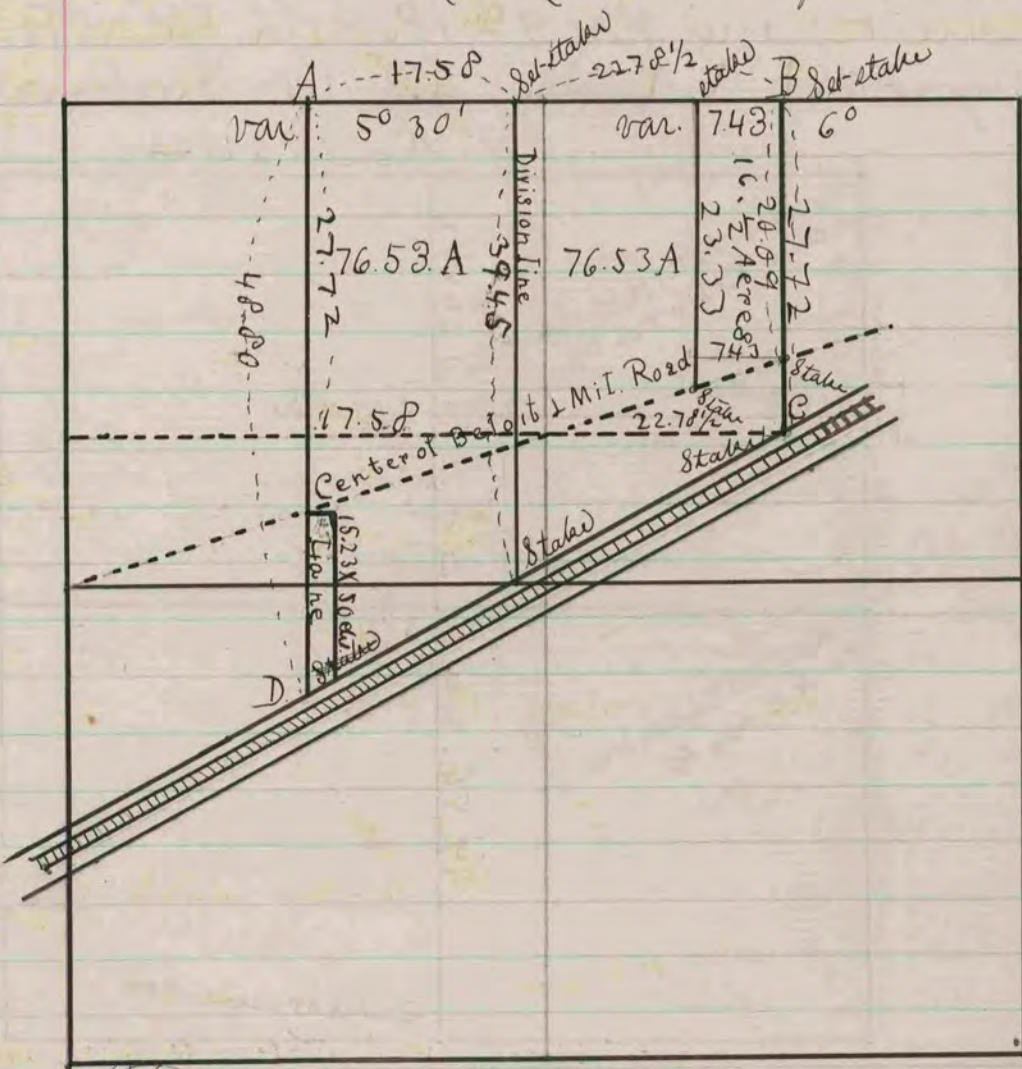

The above is a correct record and plat of a survey made by me Dec. 13. 1869. On. Sec. 9. Clinton R. R. Sec. Dep. Co. Surveyor.