



see Sec. 1 preceding page

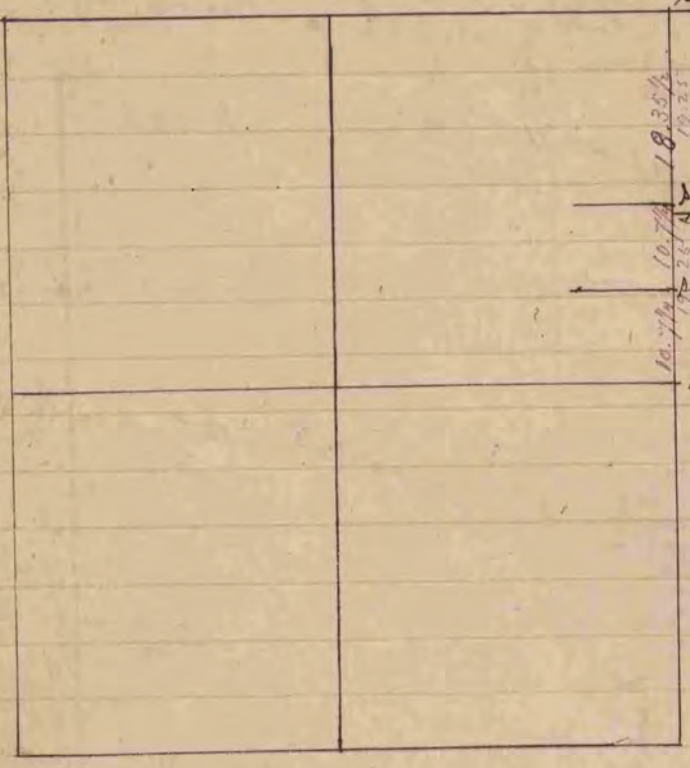

COUNTY SURVEYOR
RECORD 1 1851-1869

A Record & Plat of a survey made on Sec. 2 T. 3 N. R. 11 E
by L. Locke County Surveyor in and for Rock Co. Mis.

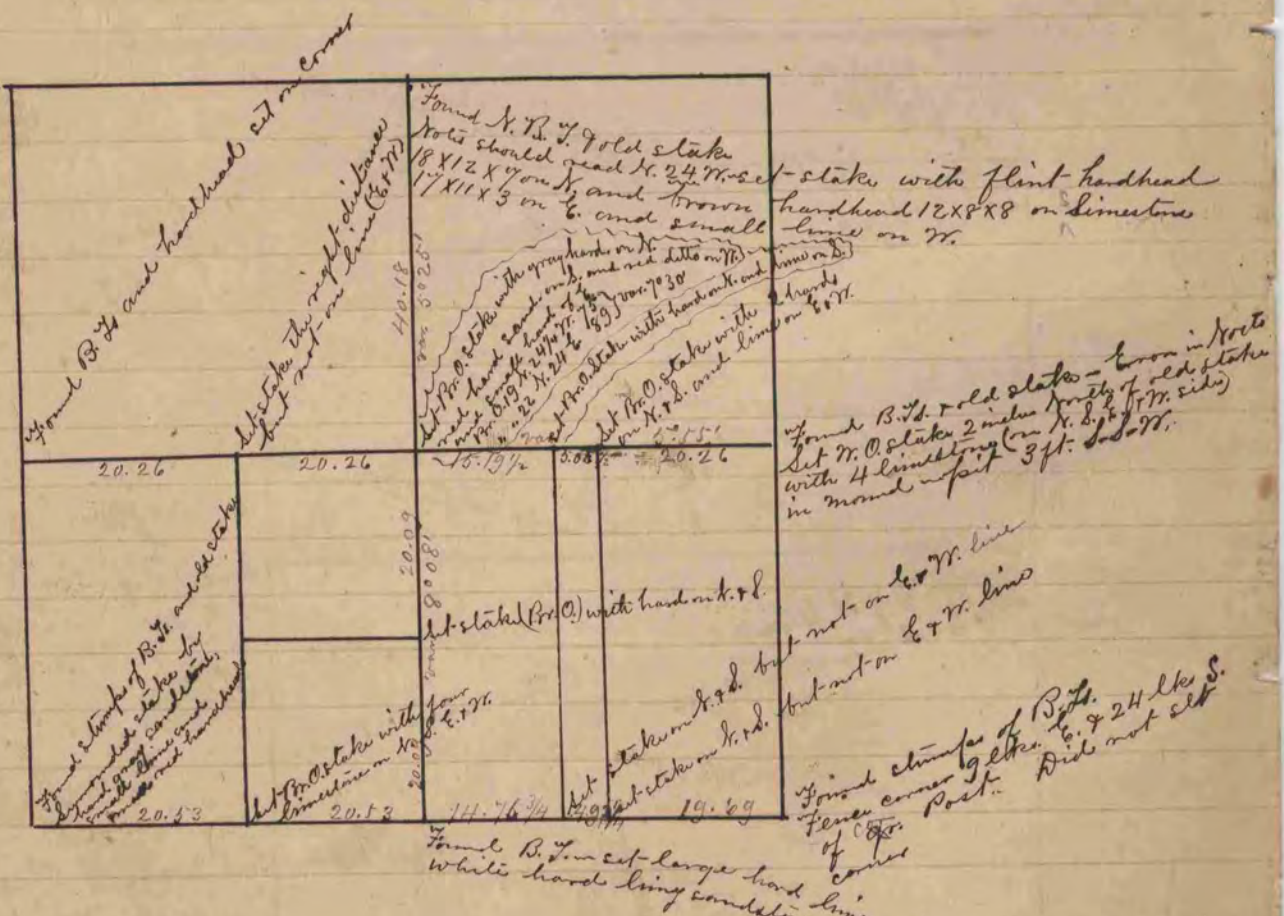

A Record & Plat of a survey made on Sec. 12 T. 2 N. R. 11 E
of July 15th 1864, by L. Locke Co. Surveyor in and for Rock Co. Mis. Chapman