


The above is a correct Record & Plat of a Survey made by me in September, 1865, on Sec. 3 in the Town of Rock -

S. D. Locke, County Surveyor Rock Co. Wis.

COUNTY SURVEYOR  
RECORD 1 1851-1869

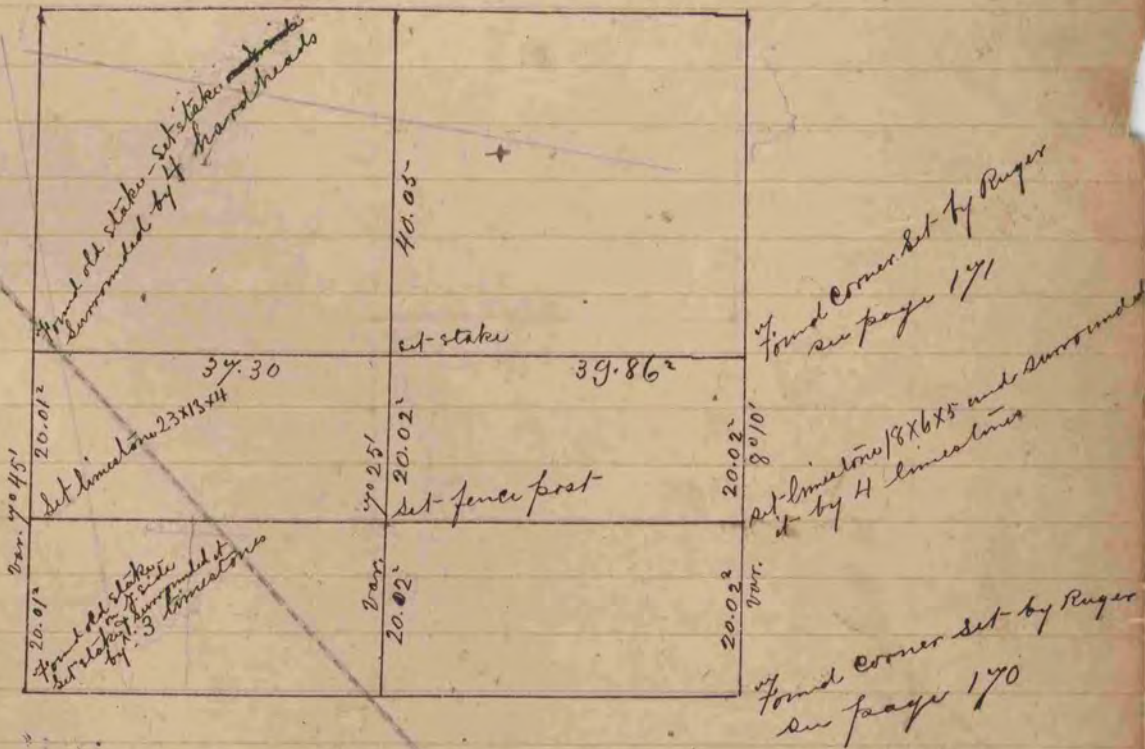

The above is a correct Record & Plat of a Survey made by me in April and September 18<sup>th</sup> 1865, on Sec. 7 in the Town of Laprairie

S. D. Locke County Surveyor  
Rock Co. Wis.