


Fig 4 Represents the N.E. cor. of the N.W. qr of the N.W. qr Sec.
 " " N.O. 28 N. 74 1/4 W 62 also N.O. 8 38 1/2 E 46

The above is a correct Record & Plat of a survey
 made by me on Sec. 14, T. 1. R. 13. Tulle
 June 1st 1854

Peter McLean Co. Surveyor

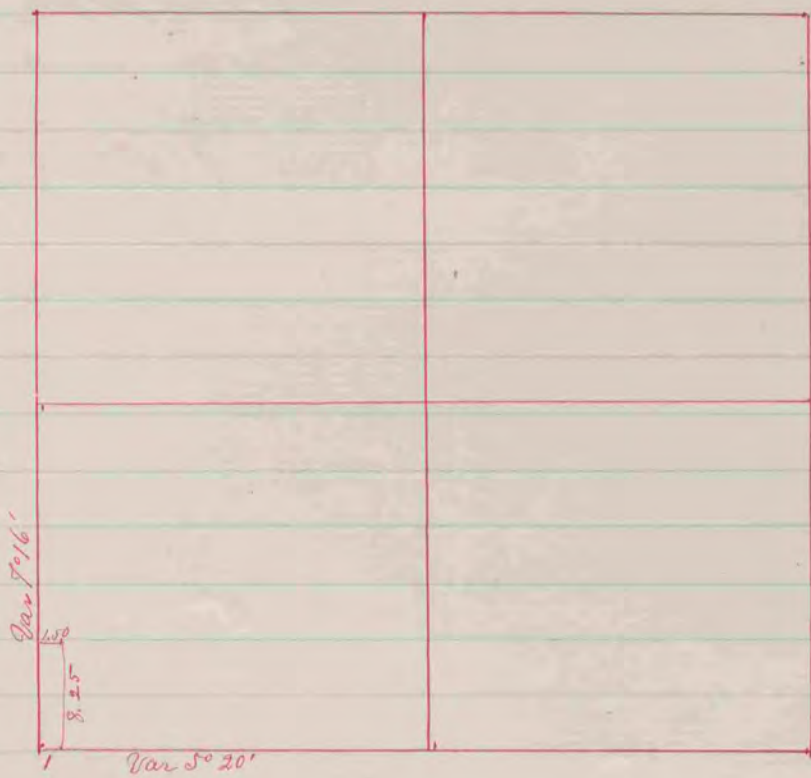

A Record & Plat of a Survey made in Sec. 1, T. 1, R. 18
 for Swingle Feb. 24 By

Edward Rizer

COUNTY SURVEYOR
 RECORD 1859-1908