


COUNTY SURVEYOR  
RECORD 1859-1906

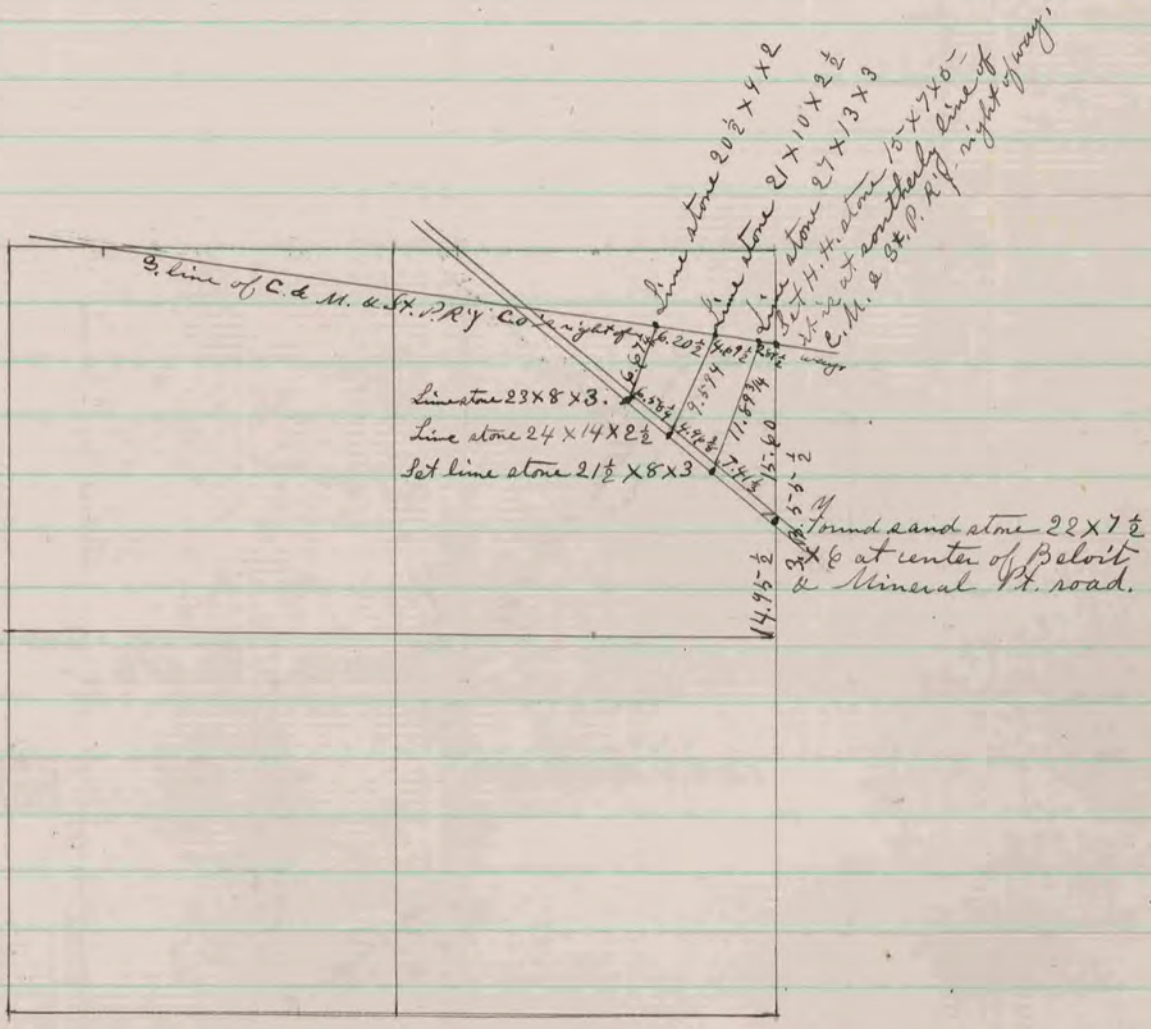

(See page 520)

The above is a record and plat of a  
 survey made by me on Sec. 24 Spring  
 valley - May 21 1886  
 Edward Ruger  
 County Surveyor,

COUNTY SURVEYOR  
RECORD 1859-1906