


The Above is a correct Record & Plat of a Survey made by me June 11-12 1869, on Sec. 25, T. 1, R. 13. Turtle
 R. K. Lee Dep. Co. Surveyor

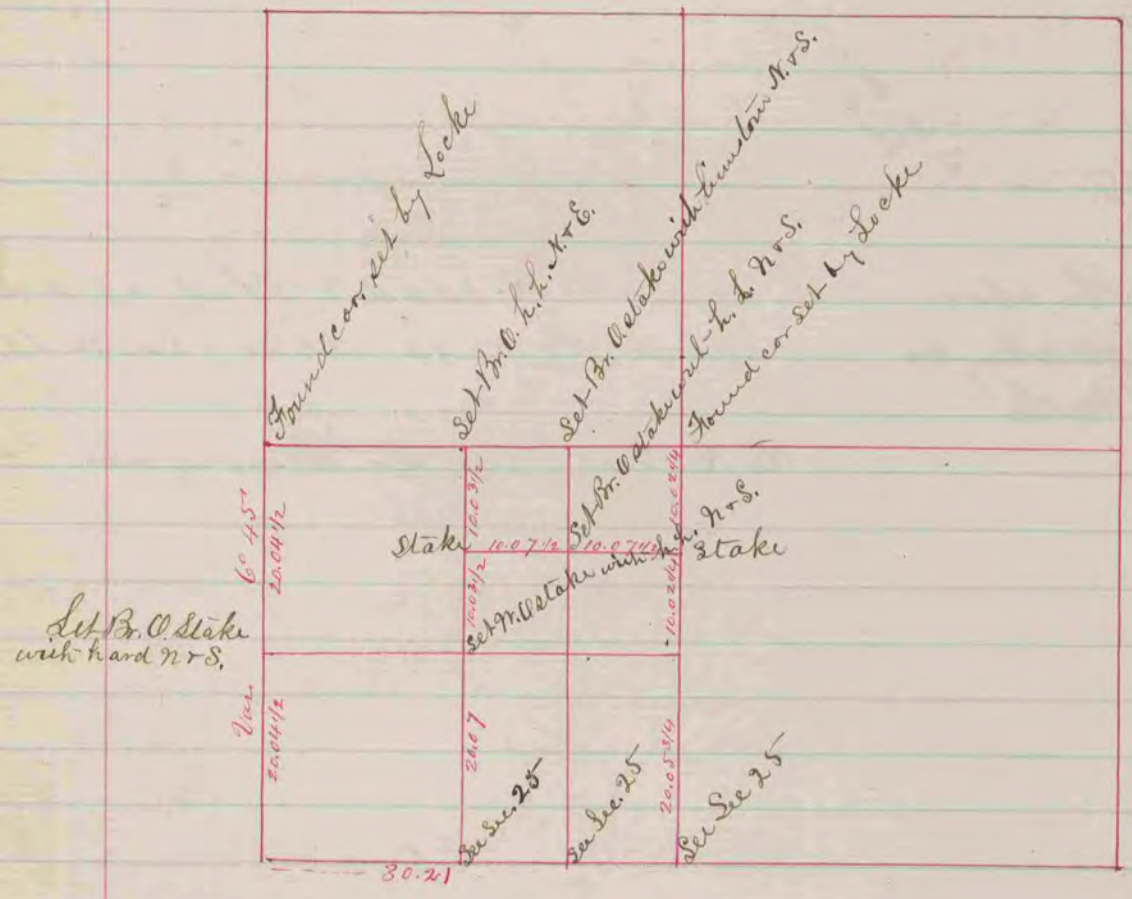

The above is a correct Record & Plat of a Survey made by me June 12, 1869 on Sec. 24, T. 1, R. 13 Turtle
 R. K. Lee Dep. Co. Surveyor

COUNTY SURVEYOR
 RECORD 1859-1906