

A Record and Plat of a Survey made on Dec 27  
 Eight town two Range Eleven East

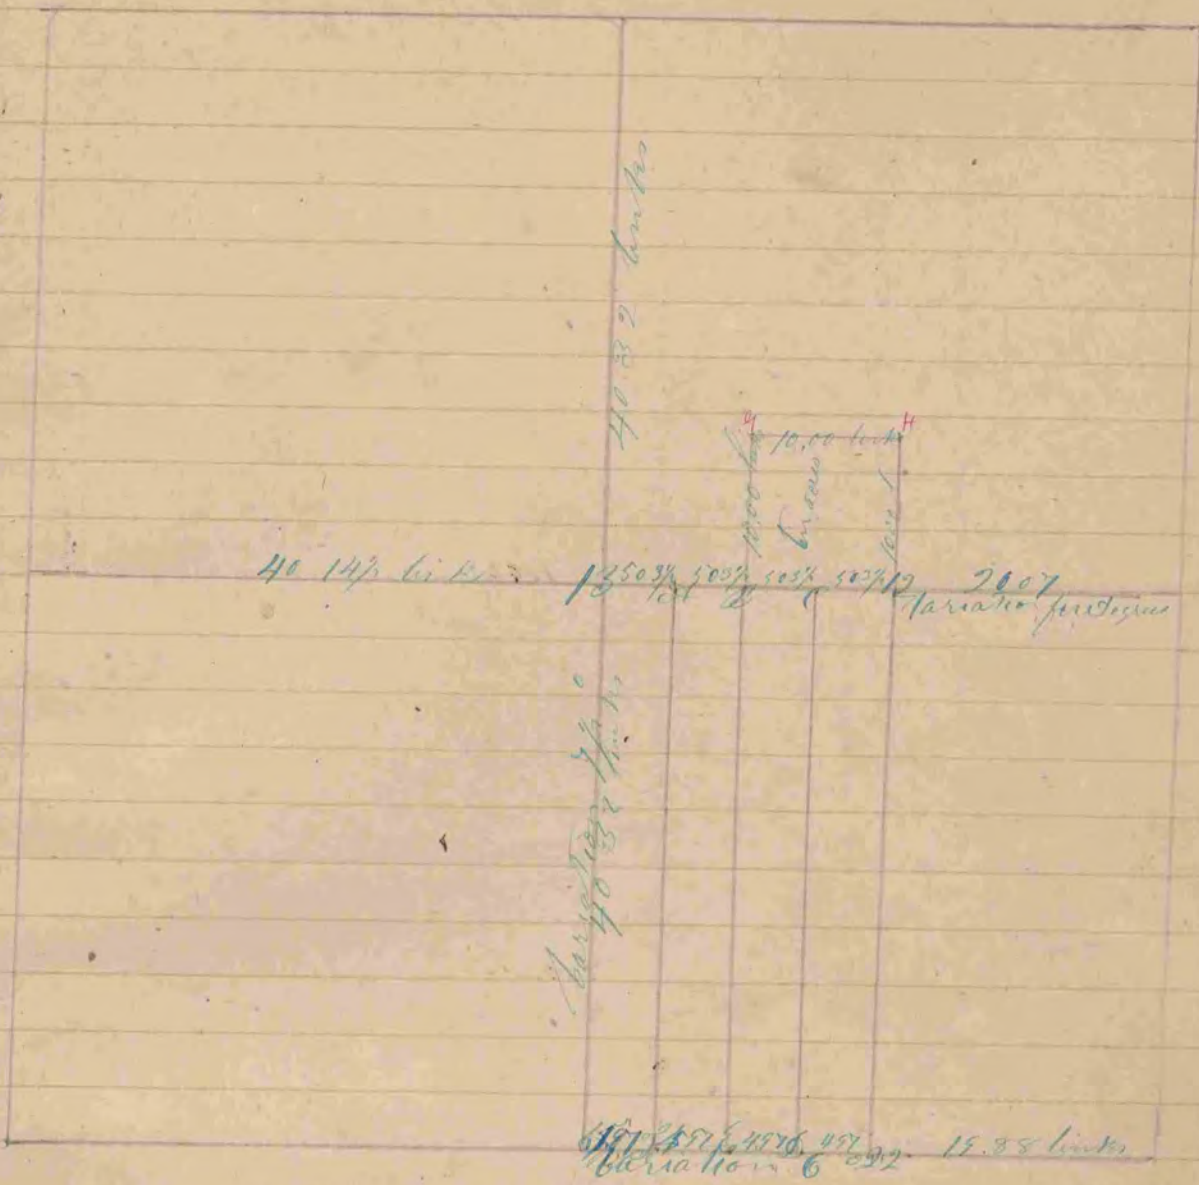


Fig 13 Represents Centre of Sec

" W O 6 2 88 E 21.74 links Variation 4 degrees

" 12 Stake no bearings

22 Stake ..

23 Government as part

Letters A B C D E F G H Stakes no bearings  
 Plymouth

The above survey was made on the 25th day of Jan 1858  
 Joseph Church County Surveyor  
 Rock County Wis