


*found by B. F. ...
set ... 15x7x6*

190

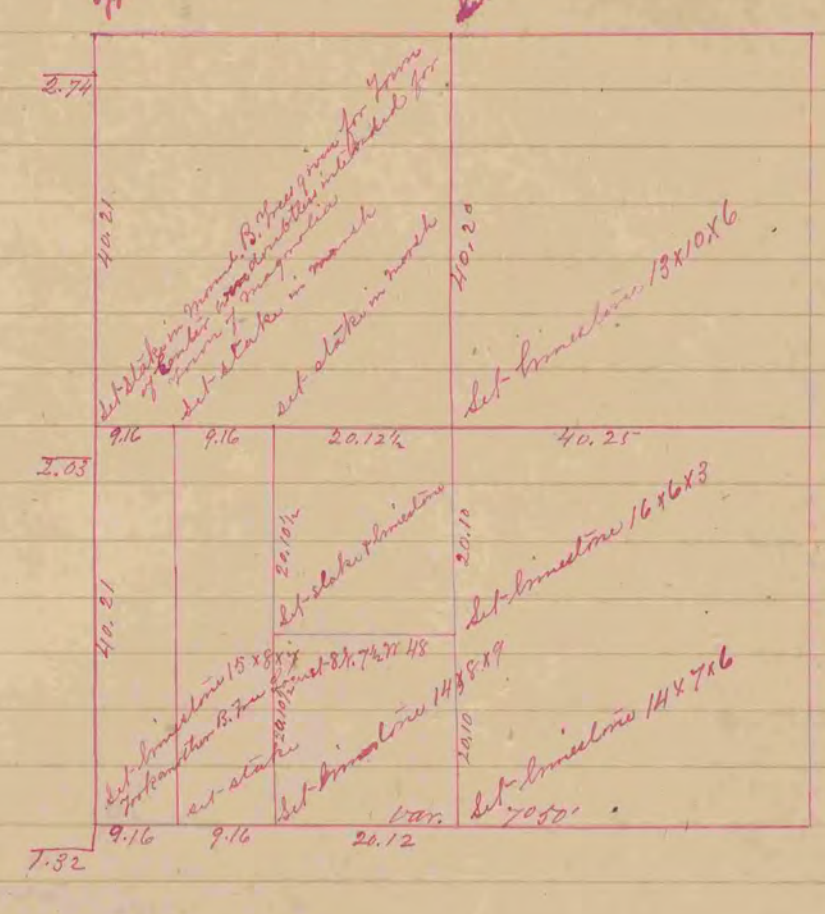

Record & Plat of a survey made June 11, 1863 on Sec. 18, T. 3, R. 11 E.,
by S. D. Locke, County Surveyor, in and for the County of
Proctor, Wis. - Center

COUNTY SURVEYOR
RECORD 1 1851-1869