


A Record & Plat of a Survey made Dec. 10, 1863, on Sec. 10, Twp 3, R. 10 E., by S.H. Locke, County Surveyor in and for Rock County, Wisconsin 198
Magnolia



A Record & Plat of a Survey made Dec. 11, 1863, on Sec. 4, 7, 3, R. 10 E. by S.H. Locke, County Surveyor in and for Rock County, Wis. *Magnolia*

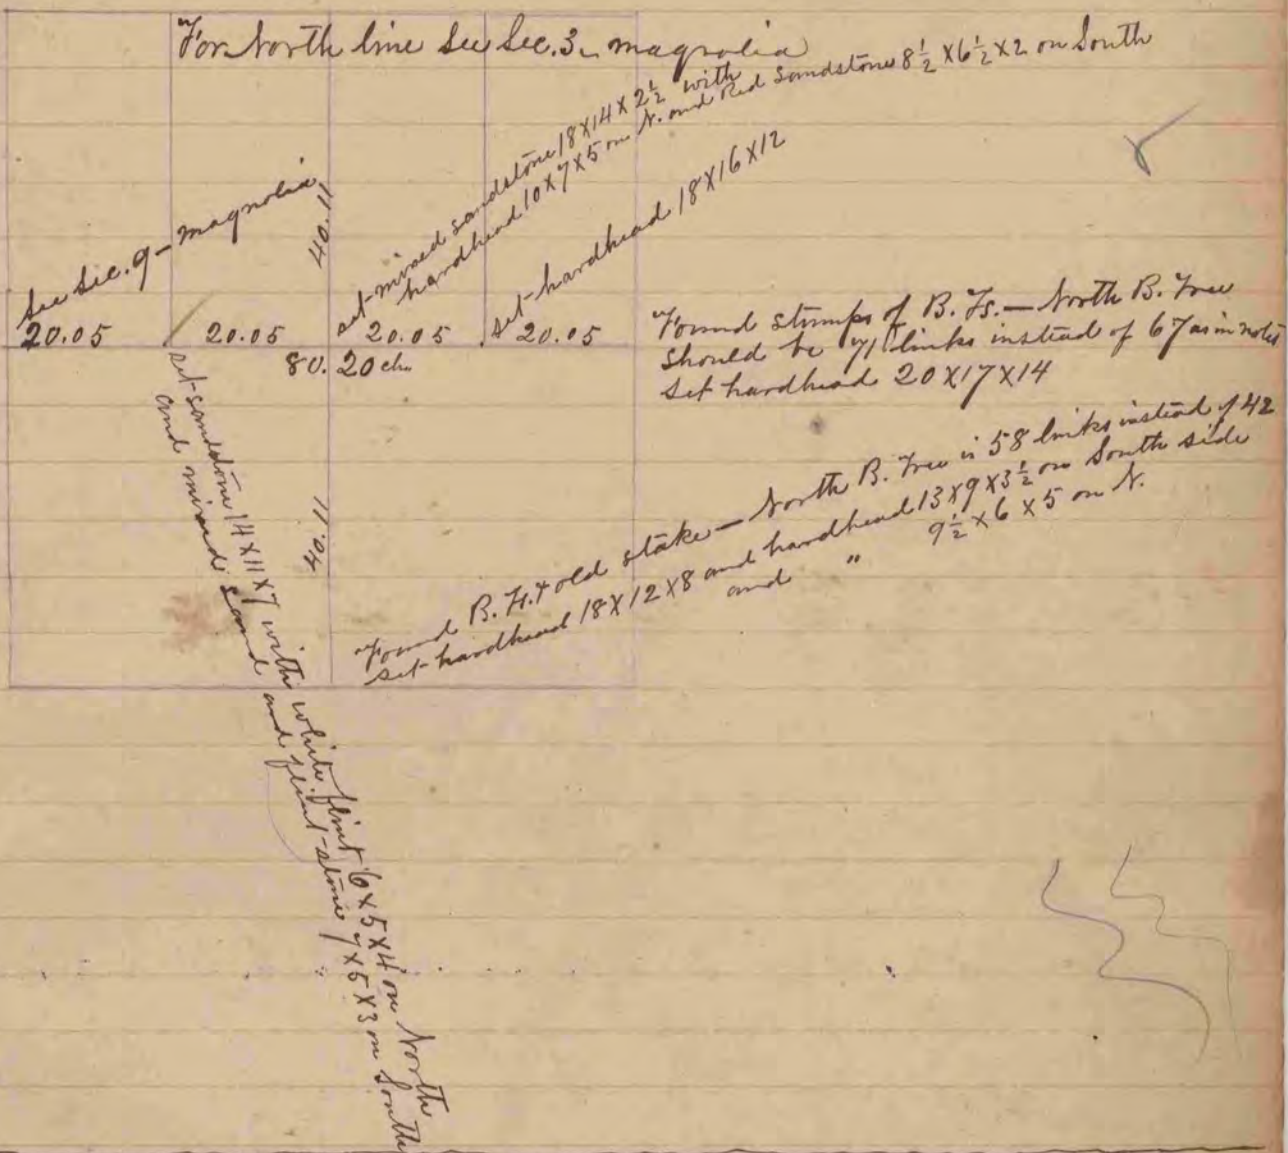