


RECORD 1859-1906
COUNTY SURVEYOR

Found old stake. Drove new stake deep in place of old one & put on top of it lime stone 14x6x2 & surrounded by 4 small hard head stakes.

Found old stake. Drove new stake deep & put on top of it lime stone 18x8x4 & put lime stone on North side & hard head stone on South side.

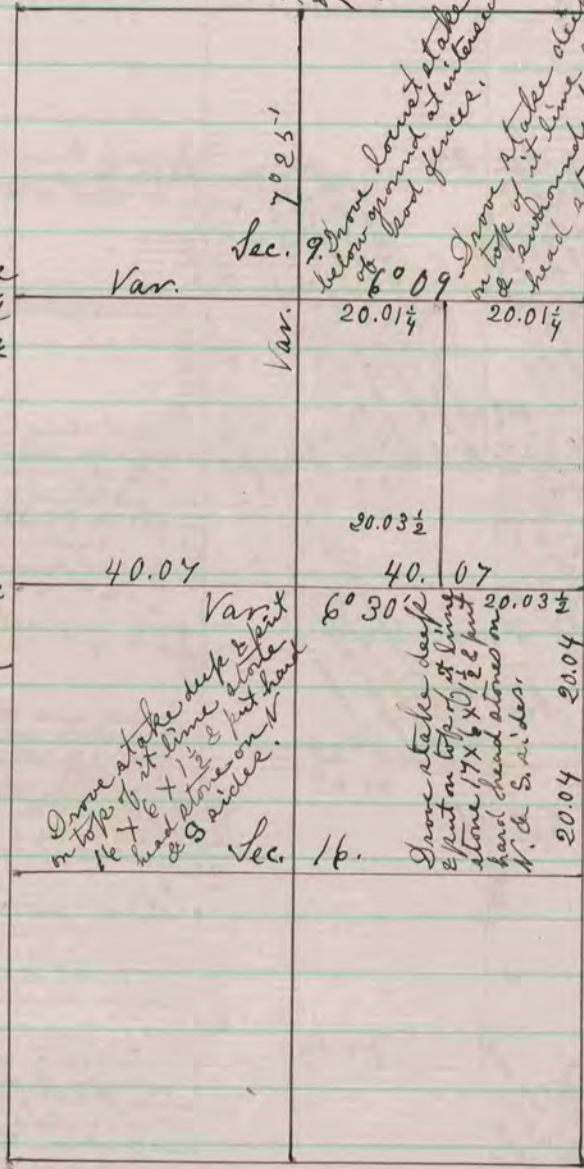

Found old stake. Drove new stake in place of old one & put on top of it hard head stone 18x11x8 & surrounded it with 2 lime & 2 hard head stones.

Drove stake deep & put on top of it lime stone 17x6x1 1/2 & put hard head stones on N. & S. sides.

Drove stake deep & put on top of it lime stone 18x8x4 & put lime stone on N. & S. sides.

Found old stake. Drove new stake deep & put on top of it lime stone 14x6x2 & surrounded by 4 small hard head stakes.

Var. 8'00"

You covers on this line. See by 350 & Sec. 3. 317, 318 & 319

The above is a record & plat of a Survey made by me on Sections 9 & 16 Bradford - June 2 - 1874

Edward Ringer
County Surveyor