


Set line above  $14 \times 9 \times 2\frac{1}{2}$   
+ put down 2 line above of this class

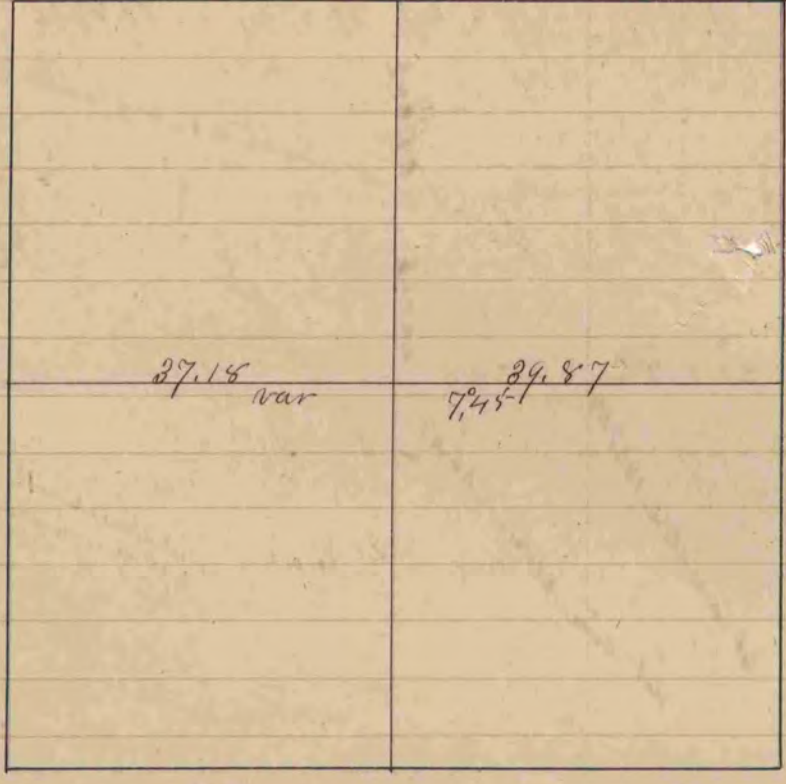

A record and plat of a survey made on section 18  
 Town 3 Range 12 April 17<sup>th</sup> 1860  
 J. A. [unclear] by Edward [unclear] County Surveyor  
 for Rock County Wis

COUNTY SURVEYOR  
 RECORD 1 1851-1869