


The above is a record & plat of a survey made on Sec. 11  
 Jamesville, May 14-1872. by R. T. Lee.

Dep. Co. Surveyor.

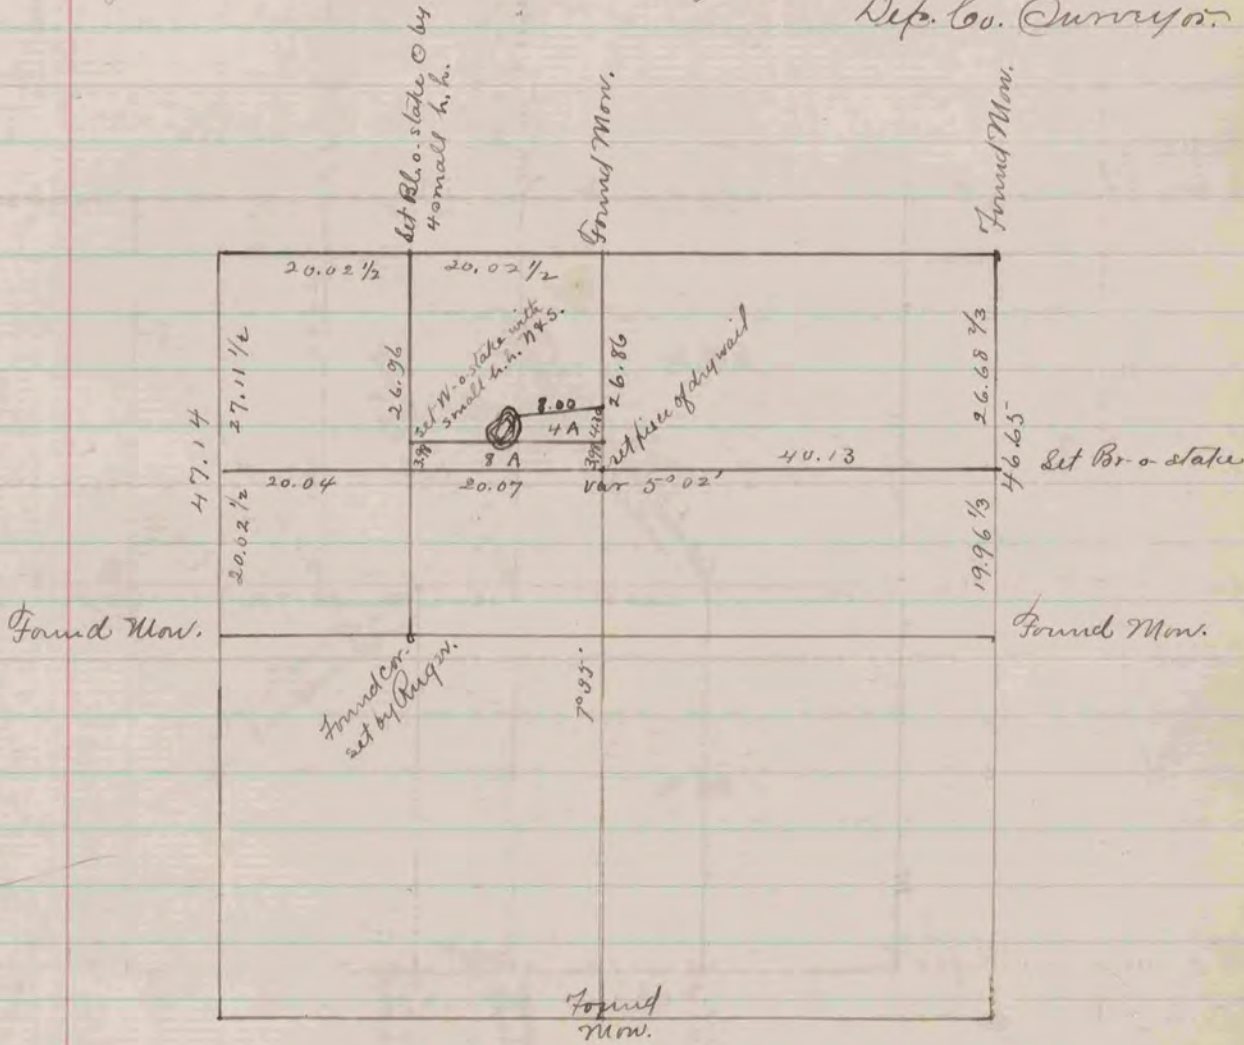

This above is a record & plat of a survey made on Sec. 5  
 Harmony June 6, 1872. by  
 R. T. Lee

Dep. Co. Surveyor.