

Sec 12. Beloit.


Found a lime stone set in a mound
 in the Highway said by Israel
 Henderson & Clark to have been placed
 when the post stood in the Spring of 1863

N. 40° W or Var of 40°
 39.93
 Set several stakes
 on a right line
 between.

lime stone said by A. Henderson
 to be set where the Gov. stake stood
 in the Spring of 1863 & said
 marked ^{stake} stood beside the stone
 for several years.

A record & plat of a survey made
 by me of the West line of N.W. 1/4 of Sec
 12 in Beloit May 7th 1882
 J. A. Holmes
 Co. Surveyor.

Sec 8 Fuzzon East & West 1/4 line
 June 22nd 1882

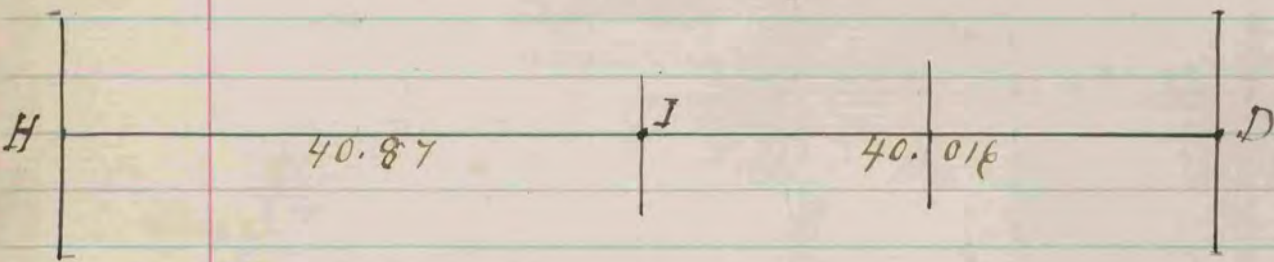

At D found stones & stump as described on Page
 314.

Run line on a var. 70° 15' passing 2 ft with Hand
 at H. & 1/2 like N of stone at the N. side of fence post.
 The point H being not regarded as satisfactory
 further investigation was deferred, but shows the
 monuments very nearly in a direct line

J. A. Holmes
 Co - Surveyor.