



Found cor. set by Roper

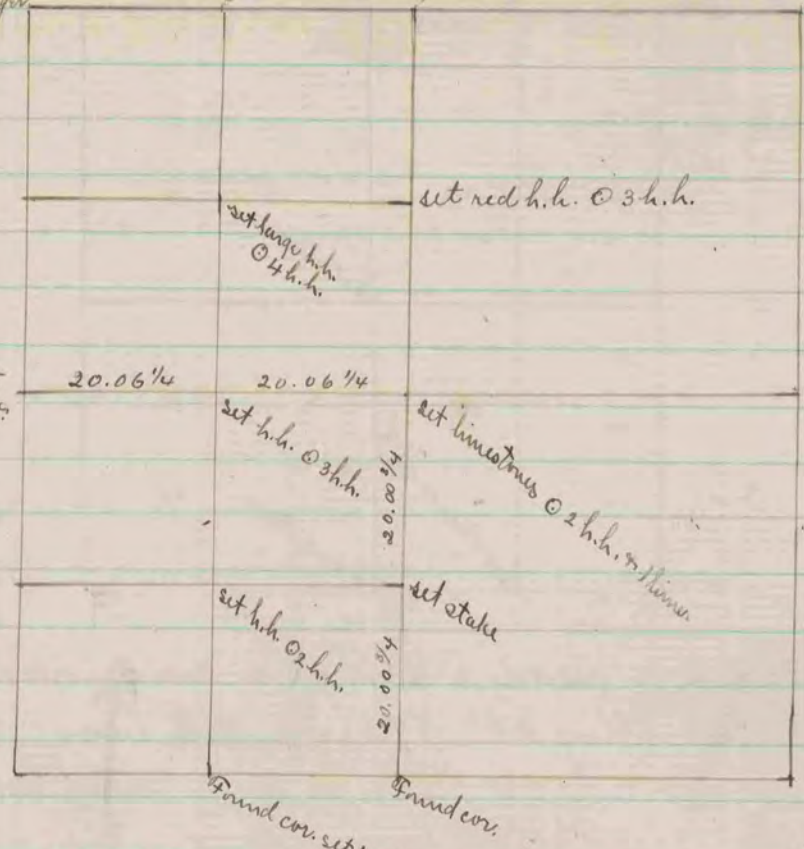

The above is a plat & records of a survey made by me on Section 29 Bradford, June 3 & 4, 1873 by R. K. Lee Dep. Co. Surveyor.

At 40.00 found cor. set by Graves of Darw. Co.

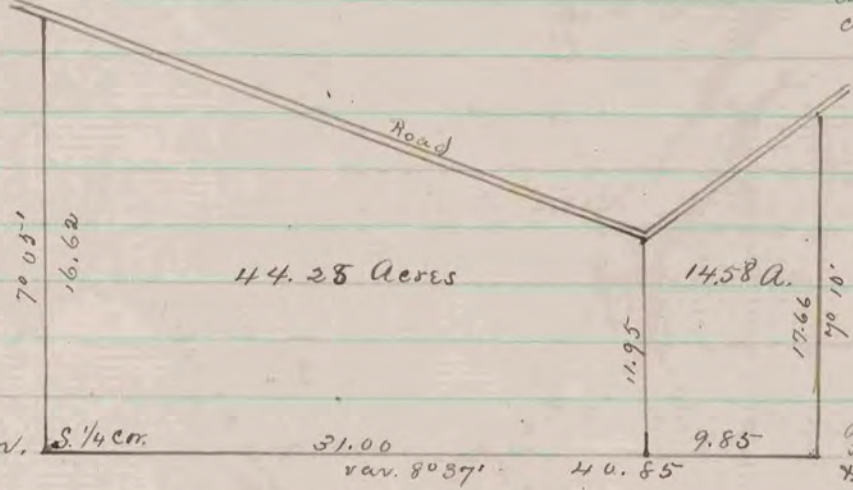

at 20.00 found cor set by Graves.

Found stake & stones & stump of S.S. B.T. which should be Bl.O. instead of Br.O.

The above is a record & plat of a survey made on Sec. 5 Porter, June 6, 1873, by R. K. Lee Dep. Co. Surveyor.