


See South  $\frac{1}{4}$  corner of Section 12 Page 447

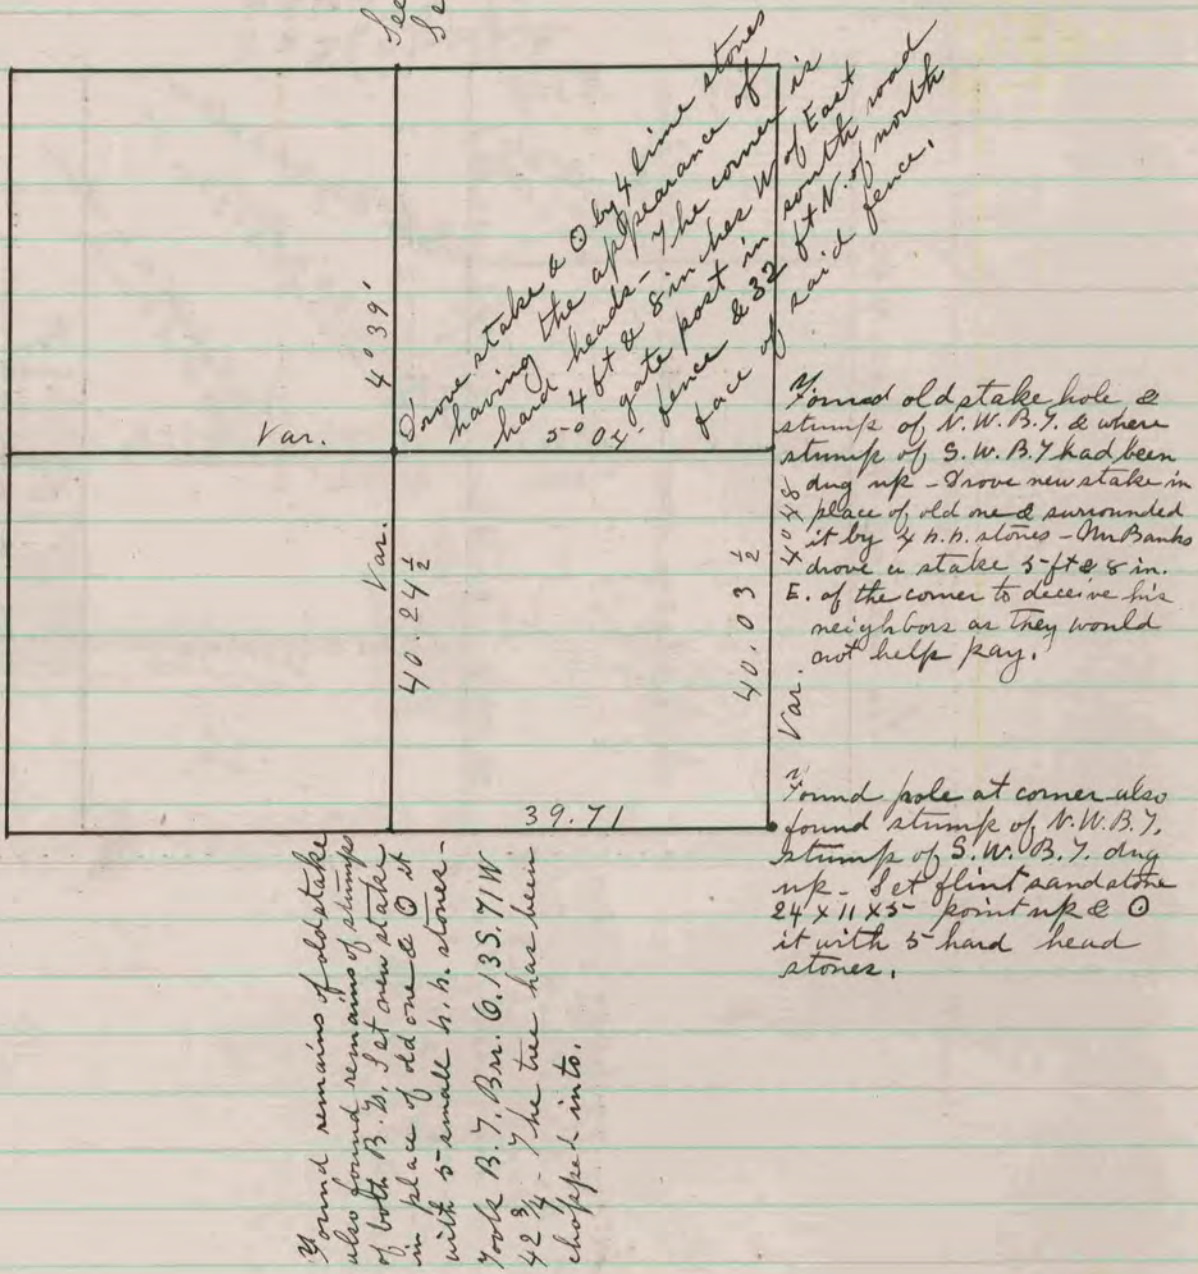

The above is a record & plot of a Survey made by me on Section 13 Lima June 13- 1876.

Edward Ruger  
County Surveyor.