


A Record and plat of a survey made on Sec twelve town three Range
ten East

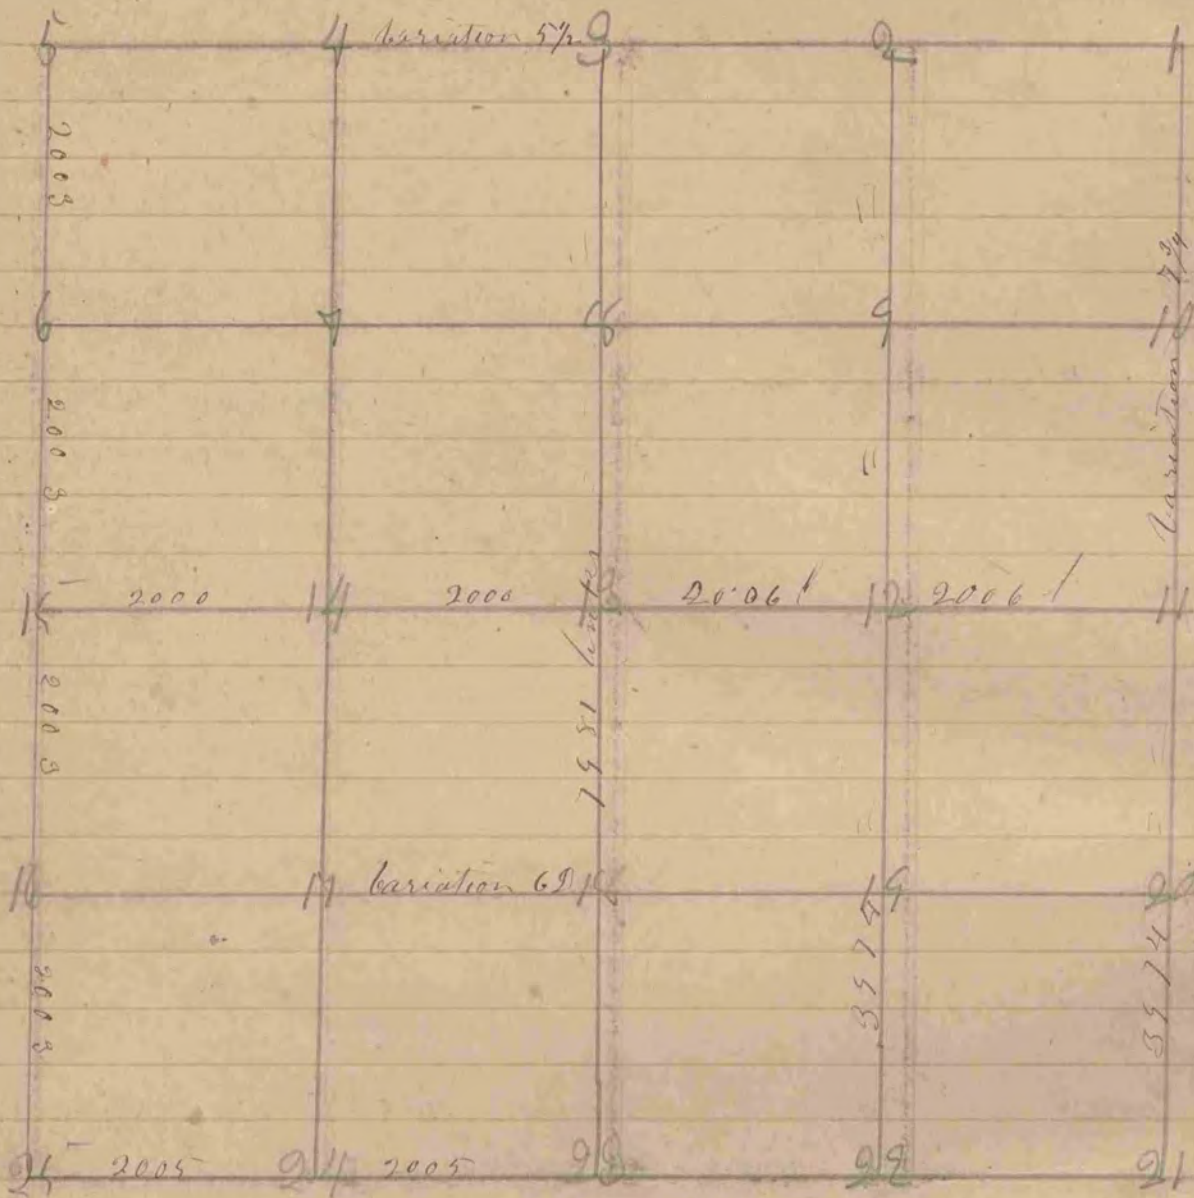

The above survey was made in the month of August 1855
and the distances as marked down on the map
Stakes were drove into ground at figures 6-7-8-9-10
no bearings

Joseph Church
County Surveyor
Tenth County Mo