


Stone Monument,

Stone Monument,

Planted hard head stone  
16 x 9 x 8.

Planted hard head stone  
20 x 8 x 7.

Stone Monument,

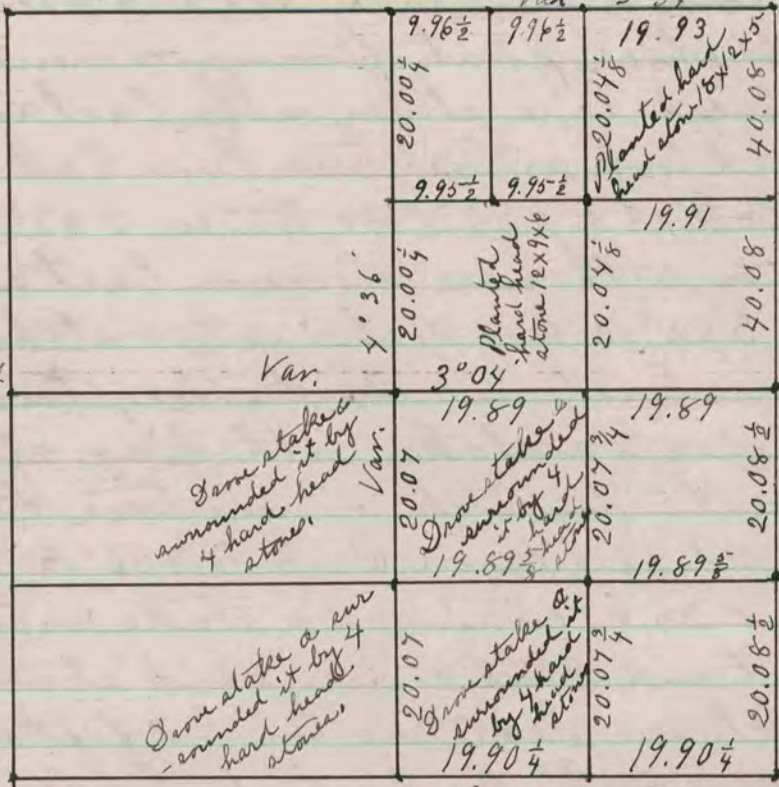

Stone Monument

Stone Monument.

Stone Monument

Stone Monument,

Stone Monument

Drove stake deep & put on top of it sand Stone 14 1/2 x 14 1/2 x 9.

COUNTY SURVEYOR  
RECORD 1859-1906

The above is a record and plat of a Survey made by me on Section 22 Milton June 28-29 & 30 - 1875-

Edward Ruger  
County Surveyor.