



REC VOL 1 PG 337

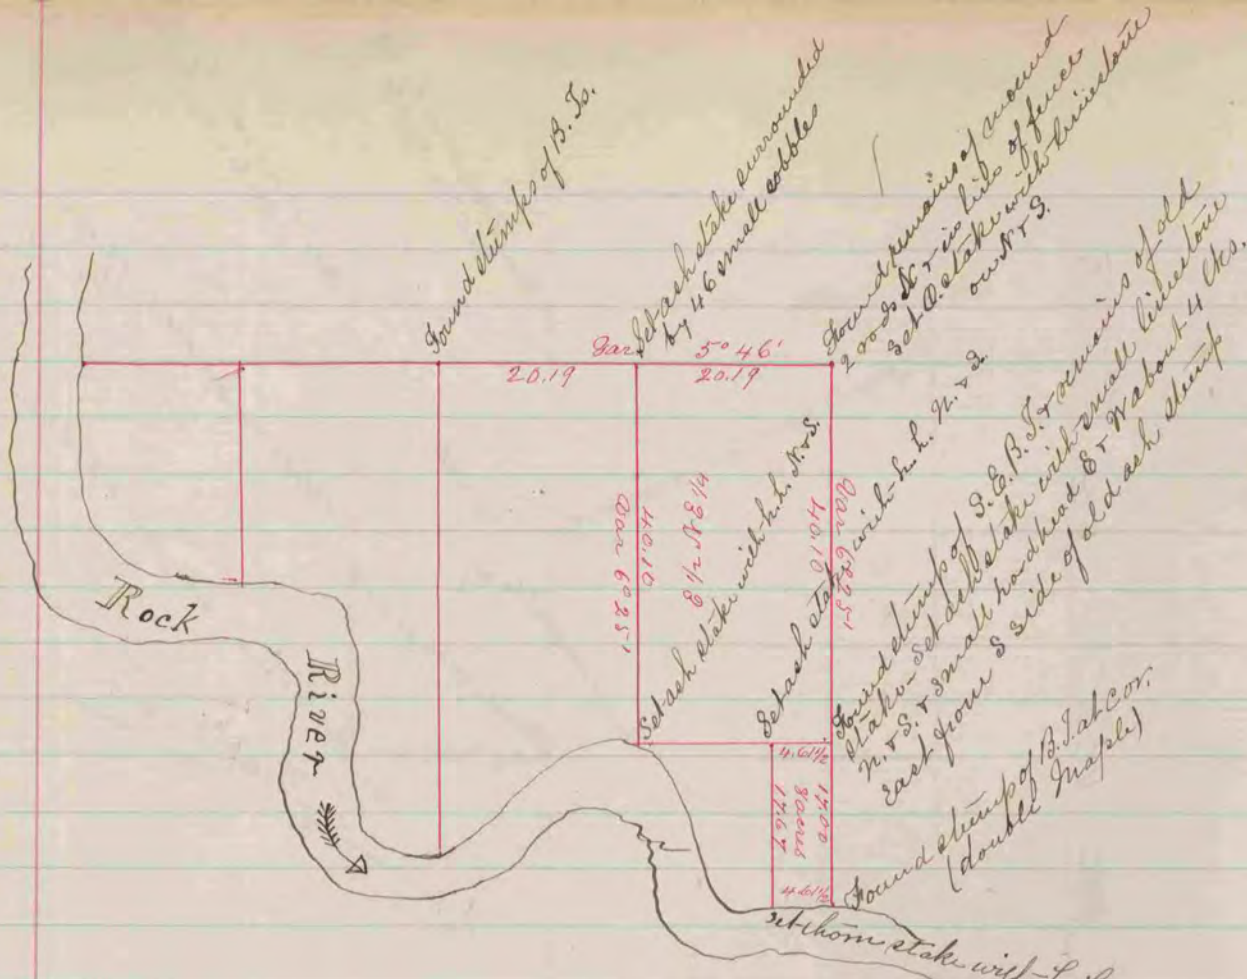

The above is a correct Record & Plat of a Survey made by me March 9 - 1869 on Sec. 27. T. 2. R. 12. Rock
 R. H. Lee dep. Co. Surveyor

REC VOL 1 PG 345

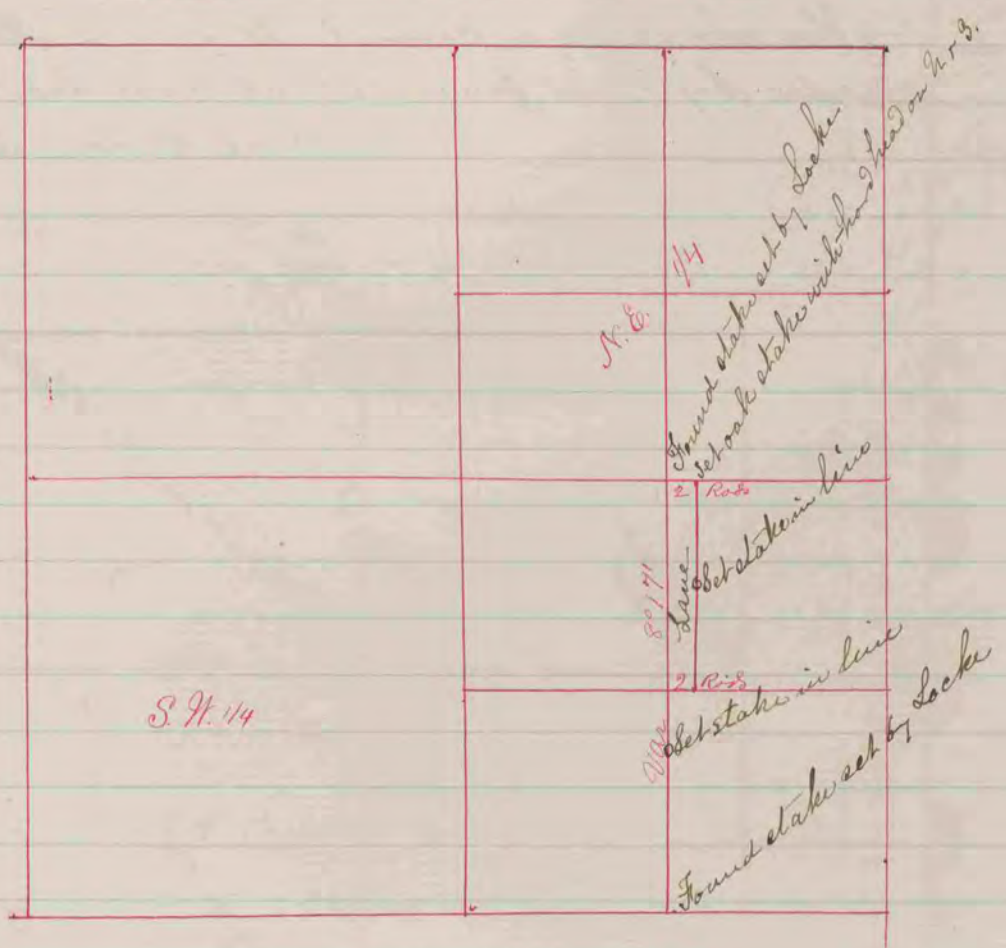

The above is a correct Record & Plat of a Survey made by me May 26 - 1869 on Sec. 8. T. 2 R. 12. Rock
 R. H. Lee dep. Co. Surveyor

COUNTY SURVEYOR
 RECORD 1859-1906