


Record of a survey of Sec. 9 Town of Rock

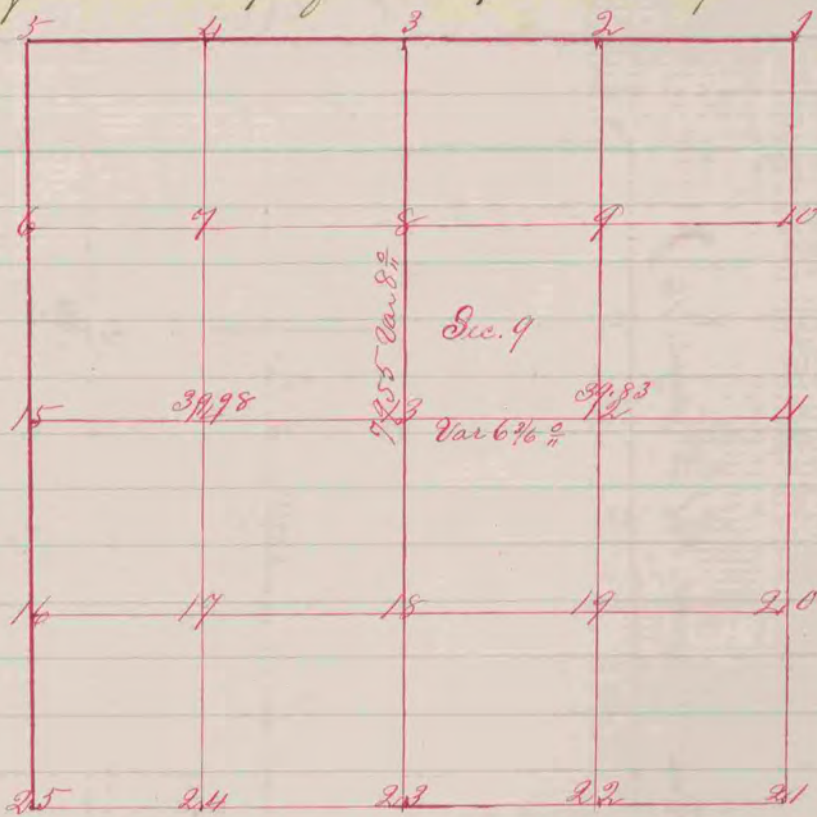

- Fig 13 represents the center of the Sec.
 " 13 Post in field
 " 12 " " Prairie
 " 18 " " field
 " 19 " " "

The above survey was made March 4, 1858
 Peter McLean Co. Surveyor

(Recorded in Vol I page 17)