


Found stump of N.E. 1/4 & remains of old stake - Stump of S.W. 1/4, each - ed out of set line stone 24 x 9 x 8.
 Found stake & surrounded it by 3 hard head stones & one lime stone.
 Found old stake & stump of both B. 1/2. Stake correct. Drove new stake in the place of the old one & surrounded it by 4 hard head stones.

Found old stake & decayed stumps of both B. 1/2. Drove new stake in place of old one & put hard head stone on the N. & S. sides.
 Found stake with hard head stones on the N. & S. sides.

Found stake surrounded by 3 hard head stones. Also found decayed stumps of both B. 1/2. Stake correct.

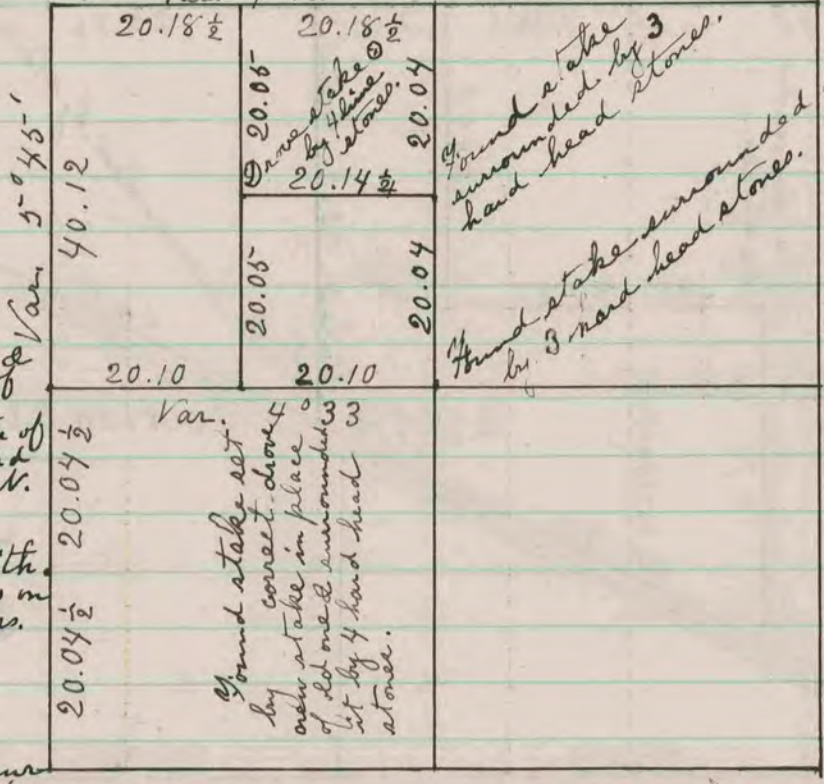

The above is a record and plat of a Survey made by me on Section 24 Turtle. Aug. 29 & 30 - 1876
 Edward Ringer
 County Surveyor.