


The above is a correct Record & Plat of a Survey made by me Dec. 21/22, 1866 on Sec. 14, Town of Harmony - S.D. Locke County Surgo. Rock Co. Wis.

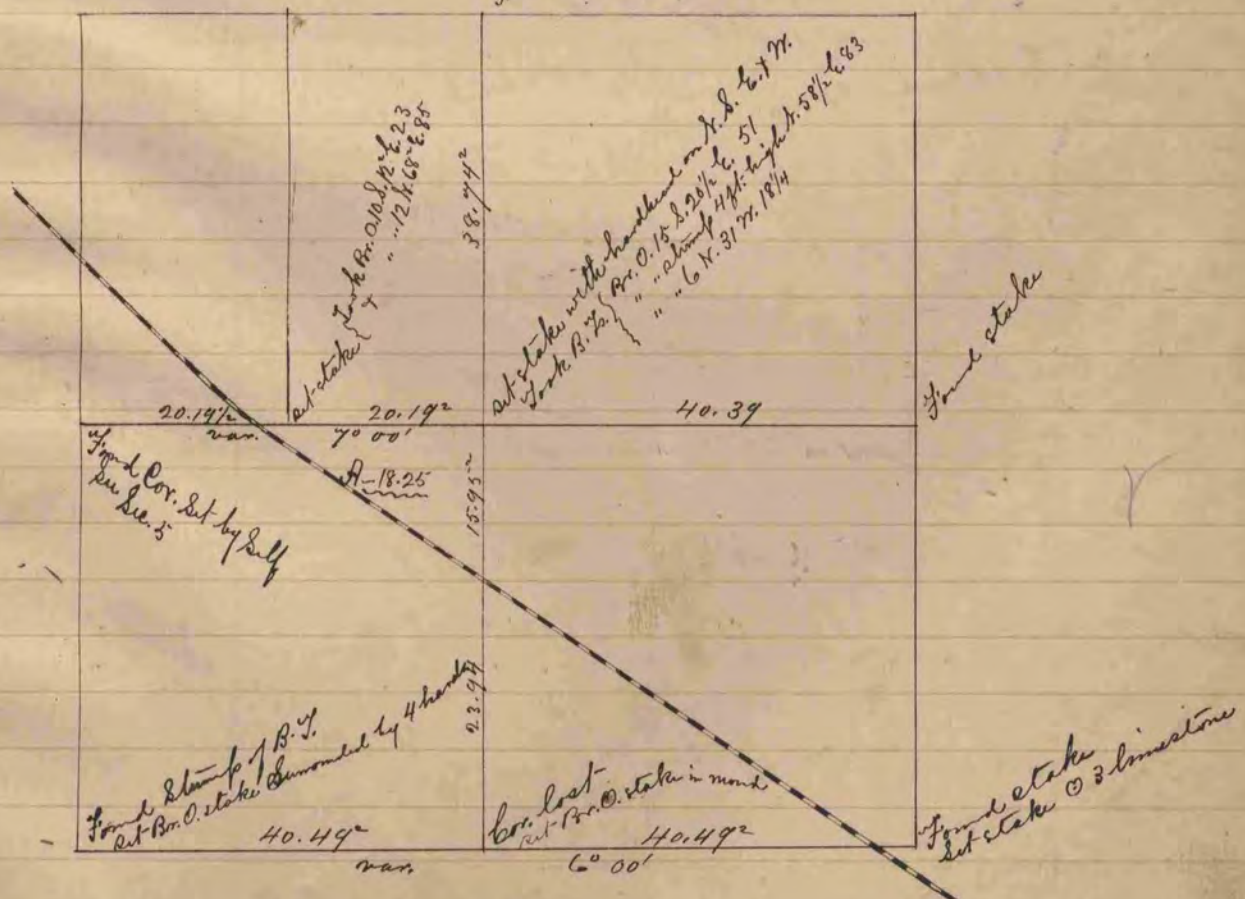

The above is a correct Record & Plat of a Survey made by me Dec. 27, 1866, on Sec. 4 - Plymouth - S.D. Locke, County Surgo. for Rock Co. Wis.